

JAN 27 2000

SECTION

LAND CORNER RECORDATION CERTIFICATE
Filing Requirement of Act 74, Mich. P.A. 1970

For corners in

HELENA TOWNSHIP

Located In:

Corner Code #

ANTRIM

(County)

1999 REMONUMENTATION

1. Public Land Survey

T 29N R 8W I-6

T R

T R

T R

2. Property Controlling in Section

S T R

S T R

3. Miscellaneous Property in Sec.

S T R

S T R

ANTRIM COUNTY MI.
Register of Deeds
Recorded

01-04-2000 09:54:14

Manda R. Conway
REGISTER OF DEEDS

Register of Deeds Stamp & File Number

4. Lot No. , Recorded Plat

5. Private Claims

I, RICHARD J. KRAL, in a field survey on November 16, 1999 do hereby state that under requirements of P.A. 74, Michigan P.A. of 1970, the corner points mentioned in lines 1 and 2 above were in conformance with regulations and rules therefore as required in the current manual of survey instructions of the United States Department of the Interior, Bureau of Land Management or by a decree of a Court of Law and /or that the corner points mentioned in lines 3, 4 and 5 above were in conformance with the rules of the Michigan Board of Land Surveyors or by a Decree of a Court of Law; established, re-established, monumented, recovered, found as expressed below:

NOTE: Not more than 2 corners, all in the same town and range, may be recorded on this certificate.

Grid with columns A-M and rows 1-13. A dot is located at the intersection of column I and row 6.

A. Description of original monument and accessories and/or subsequent restoration:

I-6: 1/4 Cor. Common to Secs. 14 & 15, T29N-R8W, Helena Township

- 10-1850, GLO Resurvey by L.S. Scranton (Deputy Surveyor) set Ironwood post, Beech 12", N8°E, 8 Lks (5.28'); Beech 6", S46°W, 34 Lks. (22.44')
- 5-1888, Survey by F.S. Church (Co. Surveyor) "found stake by roadside where road had been filled, set by Horace P. Dunn, who testified under oath that a distance marked on the stake from a mark made on a log, which he showed and that the stake was under said log, and I set the 1/4 post accordingly", Hemlock 46", West 42 Lks (27.72'); Sugar 18" S62°E, 68 Lks. (44.88')
- 5-1888, Survey by F.S. Church (Co. Surveyor), visited corner, no accessories
- 6-1968, Survey by Terrill, Kistler & Anderson, visited corner, no accessories
- 5-1986, Survey by R. Mitchell, recorded in Liber 305, Pg. 1301, set 1/2" X 18" rerod w/ cap #28417 by proration to F. Church's survey of May 1888, Rec. in Co. Surveyor record pages 62-65 on fence line to East & 1' +/- East of centerline of North & South blacktop road (Church recorded 0°03' deflection at 1/4 cor.); railroad spike, N18°29'W, 6.59'; Elm 4", N36°W, 36.24'; Basswood 6" in clump, S38°W, 54.11'; Maple 12", S60°E, 52.90'
- 5-1986, LCRC by R. Mitchell, recorded in Liber 2, Pg. 16, set 1/2" X 18" rerod w/ cap #28417 by proration to F. Church's survey of May 1888, Rec. in Co. Surveyor record pages 62-65 on fence line to East (Church recorded 0°03' deflection at 1/4 cor.); railroad spike, N18°29'W, 6.59'; Elm 4", N36°W, 36.24'; Basswood 6" in clump, S38°W, 54.11'; Maple 12", S60°E, 52.90'
- 8-1995, Survey by N. Livasy, recorded in Liber 432, Pg. 877, found 1/2" iron w/ cap #28417, railroad spike N18°29'W, 6.59'; Elm 4", N36°W, 36.24'; Basswood 6", S38°W, 54.11'; Maple 12", S60°E, 52.90'

B. Description of corner evidence found and/or method applied in restoring or reestablishing corner:

I-6: 1/4 Cor. Common to Secs. 14 & 15, T29N-R8W, Helena Township

- Found 1/2" iron rerod 3' E. of centerline N-S asphalt road, on old fence line to E.
- Pulled & replaced with Antrim County monument (Berntsten Model G-1 (30" Piston) with G-2 Cap) and mon. box.
- Fd railroad spike 1' E of centerline N-S asphalt road, N09°W, 6.58' (R. 6.59')
- Fd nail in SE side 10" Basswood in clump of 6, S39°W, 54.08' (R. 54.11')
- Set nail in SW side 6" Maple, N23°W, 82.75'
- Set nail in NE side 3" Ironwood, S54°E, 57.15'
- No G.L.O. witnesses were found.

Ratified by Peer Group
In accordance with
P.O. 345
Antrim Co. Chairman

Arthur L. Lennox
Nov. 10, 1999


C. Description of monument for corner and accessories established to perpetuate locating the position of the corner:

I-6: 1/4 Cor. Common to Secs. 14 & 15, T29N-R8W, Helena Township

- Found 1/2" iron rerod 3' E. of centerline N-S asphalt road, on old fence line to E.
- Pulled & Replaced with Antrim County monument (Berntsten Model G-1 (30" Piston) with G-2 Cap) and mon. box.
- Fd railroad spike 1' E of centerline N-S asphalt road, N09°W, 6.58' (R. 6.59')
- Fd nail in SE side 10" Basswood in clump of 6, S39°W, 54.08' (R. 54.11')
- Set nail in SW side 6" Maple, N23°W, 82.75'
- Set nail in NE side 3" Ironwood, S54°E, 57.15'

Antrim County Peer Group accepted the above monument as the best available evidence of the position of the original corner.

Signed by Richard J. Kral
Michigan License No. 26460

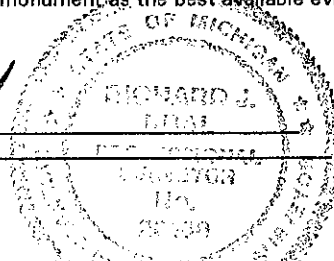

Date 12-14-99 Surveyor's