

JAN 27 2000

Liber 00003 Page 0087

LAND CORNER RECORDATION CERTIFICATE
Filing Requirement of Act 74, Mich. P.A. 1970

For corners in SECTION


ANTRIM Located In: Corner Code #
1. Public Land Survey T29N R 8W I-7
2. Property Controlling in Section S T R
3. Miscellaneous Property in Sec. S T R

ANTRIM COUNTY MI.
Register of Deeds
Recorded
12-20-1999 10:09:53
Manda R. Conway
REGISTER OF DEEDS

4. Lot No. Recorded Plat
5. Private Claims

I, NEIL L. WAY, in a field survey on 12-15, 1999, do hereby state that under requirements of P.A. 74, Michigan P.A. of 1970, the corner points mentioned in lines 1 and 2 above were in conformance with regulations and rules therefore as required in the current manual of survey instructions of the United States Department of the Interior, Bureau of Land Management or by a decree of a Court of Law and/or that the corner points mentioned in lines 3, 4 and 5 above were in conformance with the rules of the Michigan Board of Land Surveyors or by a Decree of a Court of Law; established, re-established, monumented, recovered, found as expressed below:

NOTE: Not more than 2 corners, all in the same town and range, may be recorded on this certificate.

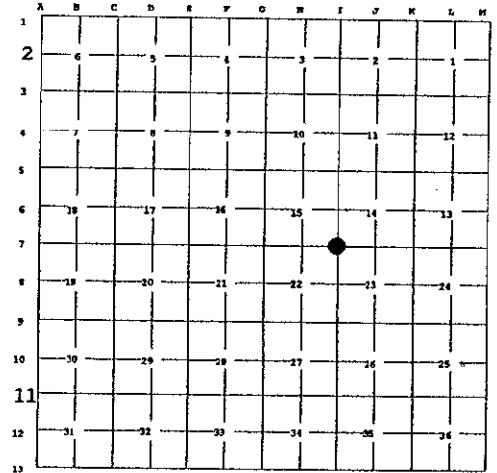

A. Description of original monument and accessories and/or subsequent restoration:

I-7 GLO SET POST 1850, BEECH 12 S61E 42, BEECH 12 N72W 40
CHURCH MAY 1888 FOUND GOV'T STK NO WIT'S. HE SUBDV. SEC 15.
MITCHELL MAY 27, 1986 FOUND A RAIL ROAD SPIKE OVER IRON THAT AGREED WITH CHURCH SURVEY ABOVE. ACCEPTED AS CORNER AND FILED LCR LIB 2 PG 017 AND CERT. LIB 305 PG 1301.

3. Description of corner evidence found and/or method applied in restoring or reestablishing corner:

I-7 FOUND RAIL ROAD SPIKE OVER IRON AND WIT'S IN AGREEMENT WITH ABOVE


Ratified by Peer Group
In accordance with
P.O. 345
Antrim Co. Chairman

Signature of Arthur L. Lennox

Arthur L. Lennox
Nov. 10, 1999

2. Description of monument for corner and accessories established to perpetuate locating the position of the corner:

I-7 REMOVED RAIL ROAD SPIKE AND REPLACED WITH COUNTY MONUMENT AND MONUMENT BOX.
N64W 84.52' P. POLE
S38E 47.48' P. POLE
S57W 59.50' P. POLE
N45W 48.20' IRON PIPE

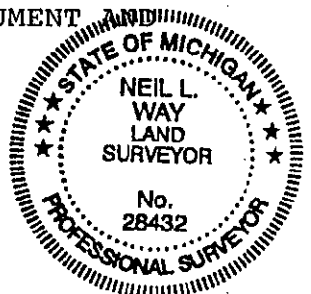

Signed by [Signature]

Date DEC 15, 1999

Surveyor's Michigan License No. 28432