

JAN 27 2000

SECTION

LAND CORNER RECORDATION CERTIFICATE  
Filing Requirement of Act 74, Mich. P.A. 1970

ANTRIM COUNTY MI.  
Register of Deeds  
Recorded

12-14-1999 13:39:39

Manda R. Conway  
REGISTER OF DEEDS

Register of Deeds Stamp & File Number

For corners in

Helena Twp.

<u>Antrim</u> (County)	Located In:	Corner Code #
1. Public Land Survey	22 T29N R 8W	I-8
	T R	
	T R	
	T R	
2. Property Controlling in Section	S T R	
	S T R	
3. Miscellaneous Property in Sec.	S T R	
	S T R	

4. Lot No. \_\_\_\_\_, Recorded Plat \_\_\_\_\_  
5. Private Claims \_\_\_\_\_

I, Terry B. Smith, in a field survey on Nov. 18 1999 do hereby state that under requirements of P.A. 74, Michigan P.A. of 1970, the corner points mentioned in lines 1 and 2 above were in conformance with regulations and rules therefore as required in the current manual of survey instructions of the United States Department of the Interior, Bureau of Land Management or by a decree of a Court of Law and/or that the corner points mentioned in lines 3, 4 and 5 above were in conformance with the rules of the Michigan Board of Land Surveyors or by a Decree of a Court of Law; established, re-established, monumented, recovered, found as expressed below:

NOTE: Not more than 2 corners, all in the same town and range, may be recorded on this certificate.

1	A	B	C	D	E	F	G	H	I	J	K	L	M
2		6		5		4		3		2		1	
3													
4		7		8		9		10		11		12	
5													
6		18		17		16		15		14		13	
7													
8		19		20		21		22		23		24	
9													
10		30		29		28		27		26		25	
11													
12		31		32		33		34		35		36	
13													

A. Description of original monument and accessories and/or subsequent restoration:

- GLO Circa 1850 -- no evidence found
- F. Church circa 1894 --
- B. Jones set 1/2" bar 1991
- C. E. Ostling reestablished corner & set 1/2" bar 1971

B. Description of corner evidence found and/or method applied in restoring or reestablishing corner:


Found 1/2" steel bars by ostling and jones measurements and peer group findings have determined that C. E. Ostling reestablished corner per recommended standards

C. Description of monument for corner and accessories established to perpetuate locating the position of the corner:

- Set Antrim Co. Monument at position of E. E. Ostling bar
- 10" Maple S45E 45.20
- 6" Maple S80E 51.40
- 18" Willow S45W 31.60
- 1/2" Steel bar #23514 S38W 4.25
- E-W fence runs to west

Ratified by Peer Group  
In accordance with  
P.O. 345  
Antrim Co. Chairman

Arthur L. Lennox  
Nov. 10, 1999

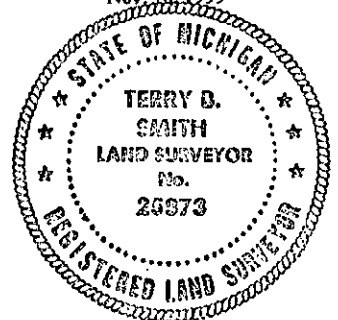

Signed by Terry B. Smith  
Surveyor's Michigan License No. 25873

Date 12-14-1999