

JAN 6 17 2000

SECTION

LAND CORNER RECORDATION CERTIFICATE
Filing Requirement of Act 74, Mich. P.A. 1970

ANTRIM COUNTY MI.
Register of Deeds
Recorded

01-04-2000 09:54:24

Manda R. Conway
REGISTER OF DEEDS

Register of Deeds Stamp & File Number

For corners in

ANTRIM
(County)

HELENA TOWNSHIP

Located In:

Corner Code #

1999 REMONUMENTATION

1. Public Land Survey

T 29N R 8W J-5

T _____ R _____

T _____ R _____

T _____ R _____

2. Property Controlling
in Section

S _____ T _____ R _____

S _____ T _____ R _____

3. Miscellaneous
Property in Sec.

S _____ T _____ R _____

S _____ T _____ R _____

4. Lot No. _____, Recorded Plat _____

5. Private Claims _____

I, RICHARD J. KRAL, in a field survey on November 17, 1999 do hereby state that under requirements of P.A. 74, Michigan P.A. of 1970, the corner points mentioned in lines 1 and 2 above were in conformance with regulations and rules therefore as required in the current manual of survey instructions of the United States Department of the Interior, Bureau of Land Management or by a decree of a Court of Law and /or that the corner points mentioned in lines 3, 4 and 5 above were in conformance with the rules of the Michigan Board of Land Surveyors or by a Decree of a Court of Law; established, re-established, monumented, recovered, found as expressed below:

NOTE: Not more than 2 corners, all in the same town and range, may be recorded on this certificate.

	A	B	C	D	E	F	G	H	I	J	K	L	M
1													
2		6		5		4		3		2		1	
3													
4		7		8		9		10		11		12	
5										●			
6		18		17		16		15		14		13	
7													
8		19		20		21		22		23		24	
9													
10		30		29		28		27		26		25	
11													
12		31		32		33		34		35		36	
13													

A. Description of original monument and accessories and/or subsequent restoration:

J-5: 1/4 Cor. Common to Secs. 11 & 14, T29N-R8W, Helena Township

10-1850, GLO Resurvey by L.S. Scranton (Deputy Surveyor), set Cedar post for 1/4 Section corner, Spruce 10", N54°W, 33 Lks. (21.78'); Cedar 12", S71°E, 27 Lks. (17.82')

5-1888, Survey by F.S. Church (Co. Surveyor), found old stake & stub of Spruce 10" N54°W, 35 Lks. (23.10') and Cedar 12" S71 1/2°E, 24 Lks (15.84'), marked Spruce 6" N68 1/2°E, 14 Lks. (9.24')

1-1961, Survey by Batzer, found remains 3" sq. Cedar stake; replaced with 1 1/4" iron pipe.

8-1995, Survey by N. Livasy, recorded in Liber 432, Pg. 877, found well point, shown corner to be at the Northeast corner of Parcel 9, no accessories

2-1996, Survey by N. Way, recorded in Liber 441, Pg. 911, found well point, shown corner to be at Northeast corner Parcel 9-B, no accessories

B. Description of corner evidence found and/or method applied in restoring or reestablishing corner:

J-5: 1/4 Cor. Common to Secs. 11 & 14, T29N-R8W, Helena Township

Found 1 1/4" iron pipe with metal fence post & wood stakes.

Pulled & replaced with Antrim County monument (Berntsten Model G-1 (30" Piston) with G-2 Cap) in place of 1 1/4" iron pipe.

Fd nail in SE side 7" Cedar, N79°E, 9.07'

Fd nail in washer in S. side 9" Cedar, N61°W, 12.53'

Fd nail in W. side 11" Cedar, S32°W, 9.89'

Fd nail in washer in W. side 11" Cedar, N08°E, 13.45'

Set nail in W. side 5" Cedar, S04°E, 19.91'

No G.L.O. witnesses were found.

Ratified by Peer Group
In accordance with
P.O. 345
Antrim Co. Chairman

Arthur L. Lennox
Nov. 10, 1999

C. Description of monument for corner and accessories established to perpetuate locating the position of the corner:

J-5: 1/4 Cor. Common to Secs. 11 & 14, T29N-R8W, Helena Township

Found 1 1/4" iron pipe with metal fence post & wood stakes.

Pulled & replaced with Antrim County monument (Berntsten Model G-1 (30" Piston) with G-2 Cap).

Fd nail in SE side 7" Cedar, N79°E, 9.07'

Fd nail in washer in S. side 9" Cedar, N61°W, 12.53'


Fd nail in W. side 11" Cedar, S32°W, 9.89'

Fd nail in washer in W. side 11" Cedar, N08°E, 13.45'

Set nail in W. side 5" Cedar, S04°E, 19.91'

Antrim County Peer Group accepted the above monument as a careful and faithful perpetuation of the position of the original corner.

Signed by Richard J. Kral
Michigan License No. 26460

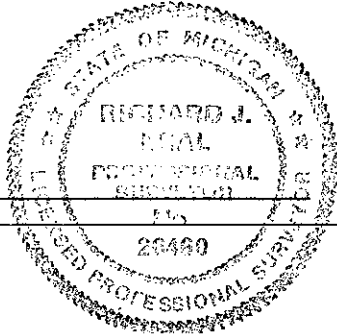

Date 12-14-99 Surveyor's