

JAN 7 2000

LAND CORNER RECORDATION CERTIFICATE
Filing Requirement of Act 74, Mich. P.A. 1970

For corners in

ANTRIM

SECTION

Located In:

Corner Code #

- 1. Public Land Survey T29NR 8W J-7
2. Property Controlling in Section S T R
3. Miscellaneous Property in Sec. S T R

ANTRIM COUNTY MI.
Register of Deeds
Recorded

12-20-1999 10:11:03


Manda R. Conway
REGISTER OF DEEDS

Register of Deeds Stamp & File Number

- 4. Lot No. Recorded Plat
5. Private Claims

I, NEIL L. WAY, in a field survey on 12-15, 1999 do hereby state that under requirements of P.A. 74, Michigan P.A. of 1970, the corner points mentioned in lines 1 and 2 above were in conformance with regulations and rules therefore as required in the current manual of survey instructions of the United States Department of the Interior, Bureau of Land Management or by a decree of a Court of Law and/or that the corner points mentioned in lines 3, 4 and 5 above were in conformance with the rules of the Michigan Board of Land Surveyors or by a Decree of a Court of Law; established, re-established, monumented, recovered, found as expressed below:

NOTE: Not more than 2 corners, all in the same town and range, may be recorded on this certificate.

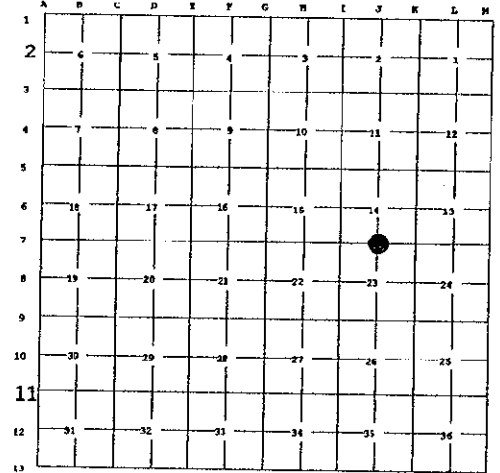

A. Description of original monument and accessories and/or subsequent restoration:

J-7 GLO SET POST 1850, BEECH 18 N39E 22, HEMLOCK 30 S18W 26 CHURCH MAY 1888 FOUND GOV'T WIT'S AND SET POST. HE SUB SEC 14 CHURCH APRIL 1894 FOUND OLD STK AND WIT'S AND SET 2" GAS PIPE WITH STONES AROUND IT. HE SUB SEC 23. MITCHELL MAY 15, 1986 FOUND IRON BAR AND STK REMAINS WITH STONES AROUND IT 28" BELOW ROAD. HE RAISED WITH 3/4" IP AND CAP #28417. AND ACCEPTED AS CORNER. HE DID NOT ACCEPT 1/2" IRON SW'LY 6' AS SHOWN ON CERT LENNOX 5-7-85. ALSO LCR LIB 002 PG 414 NOT ACCEPTED 6-27-96 SMITH.

B. Description of corner evidence found and/or method applied in restoring or reestablishing corner:

J-7 FOUND 3/4" IRON PIPE AND CAP #28417 AS DESCRIBED ABOVE.

Ratified by Peer Group
In accordance with
P.O. 345
Antrim Co. Chairman

Signature of Arthur L. Lennox

Arthur L. Lennox
Nov. 10, 1999

C. Description of monument for corner and accessories established to perpetuate locating the position of the corner:

J-7 REMOVED 3/4" IRON PIPE AND REPLACED WITH COUNTY MONUMENT AND MONUMENT BOX.

- N40W 50.68' ELM 5"
N15W 56.92' TRIP ASH 32"
S57E 100.17' MPL CLUMP 4"
S12E 81.31' CHERRY 12"
S66W 5.98' 1/2" IRON ROD UNDER NEW PVMT.



Signed by [Signature]

Date DEC 15, 1999

Surveyor's Michigan License No. 28432