

JAN 27 2000

Liber 00003 Page 0080

SECTION

LAND CORNER RECORDATION CERTIFICATE  
Filing Requirement of Act 74, Mich. P.A. 1970

For corners in

Helena Twp.

ANTRIM COUNTY MI.  
Register of Deeds  
Recorded

Antrim

(County)

Located in:

Corner Code #

12-14-1999 13:39:25

Manda R. Conway  
REGISTER OF DEEDS

Register of Deeds Stamp & File Number

1. Public Land Survey	23	T 29N	R 8W	K-8
		T	R	
		T	R	
		T	R	
2. Property Controlling in Section	S	T	R	
	S	T	R	
3. Miscellaneous Property in Sec.	S	T	R	
	S	T	R	

4. Lot No. \_\_\_\_\_, Recorded Plat \_\_\_\_\_  
5. Private Claims \_\_\_\_\_

I, Terry B. Smith, in a field survey on Nov. 18, 1999 do hereby state that under requirements of P.A. 74, Michigan P.A. of 1970, the corner points mentioned in lines 1 and 2 above were in conformance with regulations and rules therefore as required in the current manual of survey instructions of the United States Department of the Interior, Bureau of Land Management or by a decree of a Court of Law and for that the corner points mentioned in lines 3, 4 and 5 above were in conformance with the rules of the Michigan Board of Land Surveyors or by a Decree of a Court of Law; established, re-established, monumented, recovered, found as expressed below:

NOTE: Not more than 2 corners, all in the same town and range, may be recorded on this certificate.

A. Description of original monument and accessories and/or subsequent restoration:

GL0 Circa Oct. 1850 no evidence found  
F. Church April 1914 -- set gas pipe

B. Description of corner evidence found and/or method applied in restoring or reestablishing corner:

found 2 1/2" gas pipe and witnesses


C. Description of monument for corner and accessories established to perpetuate locating the position of the corner:

Set Antrim Co. Monument inside 2 1/2" gas pipe  
6" Maple N40E 24.78  
8" Ash S05W 43.72  
8" Elm N85W 56.75  
6" Maple North 45.40  
1/2" steel bar in road centerline West 33.00

1	A	B	C	D	E	F	G	H	I	J	K	L	M
2		6		5		4		3		2		1	
3													
4		7		8		9		10		11		12	
5													
6		18		17		16		15		14		13	
7													
8		19		20		21		22		23		24	
9													
10		30		29		28		27		26		25	
11													
12		31		32		33		34		35		36	
13													

Ratified by Peer Group  
In accordance with  
P.O. 345  
Antrim Co. Chairman

Arthur L. Lennox  
Nov. 10, 1999

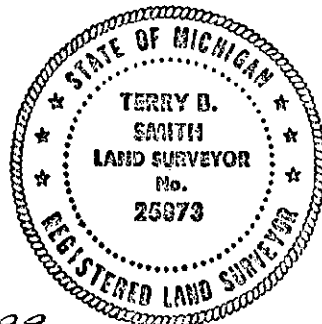

Signed by Terry B. Smith  
Surveyor's Michigan License No. 25873

Date 12-14-1999