

JAN 7 2000

LAND CORNER RECORDATION CERTIFICATE
Filing Requirement of Act 74, Mich. P.A. 1970

Lib. 00003 Page 0089
ANTRIM COUNTY MI. Register of Deeds
Recorded

SECTION

For corners in

ANTRIM

Located In:

Corner Code #

(County)

1. Public Land Survey

T29NR 8W

L-7

T R

T R

T R

2. Property Controlling in Section

S T R

S T R

3. Miscellaneous Property in Sec.

S T R

S T R

12-20-1999 10:10:23

Manda R. Conway
REGISTER OF DEEDS


Register of Deeds Stamp & File Number

4. Lot No. , Recorded Plat

5. Private Claims

I, NEIL L. WAY, in a field survey on 12-15, 19 99 do hereby state that under requirements of P.A. 74, Michigan P.A. of 1970, the corner points mentioned in lines 1 and 2 above were in conformance with regulations and rules therefore as required in the current manual of survey instructions of the United States Department of the Interior, Bureau of Land Management or by a decree of a Court of Law and for that the corner points mentioned in lines 3, 4 and 5 above were in conformance with the rules of the Michigan Board of Land Surveyors or by a Decree of a Court of Law, established, re-established, monumented, recovered, found as expressed below:

NOTE: Not more than 2 corners, all in the same town and range, may be recorded on this certificate.

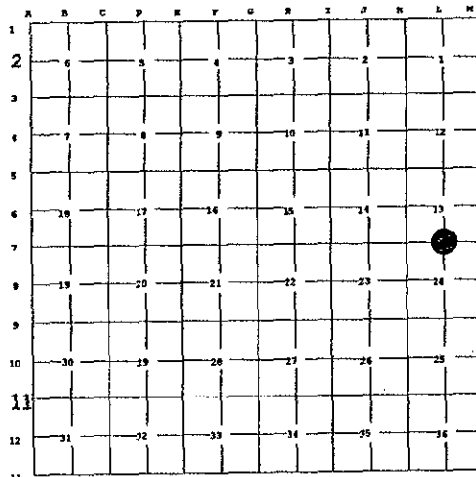

A. Description of original monument and accessories and/or subsequent restoration:

L-7 GLO SET POST 1850, BEECH 14 S28E 17, BEECH 10 N82W 27

CHURCH DEC 1887 FOUND OLD CEDAR AND MPL STK'S, GLO WIT'S GONE, SET GAS PIPE WITH STONES AND BROKEN BOTTLE AROUND IT.

KAUKIN NOV 1891 USED COR. NO WIT'S

CHURCH APRIL 1914 USED COR. STK ON N SIDE ROAD. NO WIT'S.

JONES 2-14-1989 FOUND 1/2" IRON AND MONUMENT BOX LCR LIB 002 PG 305. BY BRAND LIB 002 PG 305.

B. Description of corner evidence found and/or method applied in restoring or reestablishing corner:
BRAND END AND WIT 1/2" IR. IN MBOX LCR LIB 002 PG 305.

L-7 FOUND 1/2" IRON ROD IN MONUMENT BOX AND WIT'S IN AGREEMENT WITH ABOVE.

C. Description of monument for corner and accessories established to perpetuate locating the position of the corner:

L-7 REMOVED 1/2 " IRON ROD AND REPLACED WITH COUNTY MONUMENT AND MONUMENT BOX.

S23E 82.50' MPL 18"


N56E 64.00' W.PINE 16"

N60W 102.40' HEMLOCK 16"

N17E 96.65' P.POLE

Ratified by Peer Group
In accordance with
P.O. 345
Antrim Co. Chairman

Arthur L. Lennox
Nov. 10, 1999

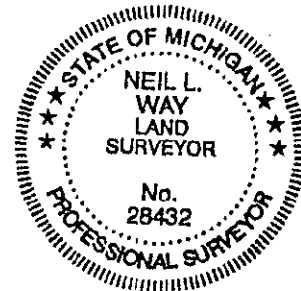

Signed by

Date DEC 15, 1999

Surveyor's Michigan License No. 28432