

FEB 18 1999

186
Liber 00003 Page 0041

LAND CORNER RECORDATION CERTIFICATE
Filing Requirement of Act 74, Mich. P.A. 1970

SECTION

For corners in

<u>Antrim</u> (County)	Located In: Elk Rapids Twp.	Corner Code # D-11
1. Public Land Survey Sec. 29	T29NR9W	D-11
	T R	
	T R	
	T R	
2. Property Controlling in Section	S T R	
	S T R	
3. Miscellaneous Property in Sec.	S T R	
	S T R	

ANTRIM COUNTY MI.
Register of Deeds
Recorded

12-28-1998 10:19:59

Wanda R. Conway
REGISTER OF DEEDS

Register of Deeds Stamp & File Number

4. Lot No. _____, Recorded Plat _____
5. Private Claims _____

I, Neil L. Way, in a field survey on Dec. 16, 1998 do hereby state that under requirements of P.A. 74, Michigan P.A. of 1970, the corner points mentioned in lines 1 and 2 above were in conformance with regulations and rules therefore as required in the current manual of survey instructions of the United States Department of the Interior, Bureau of Land Management or by a decree of a Court of Law and/or that the corner points mentioned in lines 3, 4 and 5 above were in conformance with the rules of the Michigan Board of Land Surveyors or by a Decree of a Court of Law; established, re-established, monumented, recovered, found as expressed below:

NOTE: Not more than 2 corners, all in the same town and range, may be recorded on this certificate.

A	B	C	D	E	F	G	H	I	J	K	L	M
1												
2	6	5	4	3	2	1						
3												
4	7	8	9	10	11	12						
5												
6	18	17	16	15	14	13						
7												
8	19	20	21	22	23	24						
9												
10	30	29	28	27	26	25						
11												
12	31	32	33	34	35	36						
13												

A. Description of original monument and accessories and/or subsequent restoration:

Dec. 1856- GLO set post
Feb. 1974- J. Fletcher found existing iron rod in monument box
Oct. 1989- B. Jones found 5/8 iron rod in pavement box

B. Description of corner evidence found and/or method applied in restoring or reestablishing corner:


Found iron rod in monument box

Ratified by peer group
in accordance with
P.O. 345
Antrim Co. Chairman
Arthur L. Lennox
Arthur L. Lennox
Nov. 18, 1998

C. Description of monument for corner and accessories established to perpetuate locating the position of the corner:

Set Antrim County Monument in monument box at U.S. 31 centerline

East	59.22'	Power pole (cut off)
N30°W	80.95'	Maple 40"
S35°E	117.45'	Elm 24"
N62°W	78.83'	Elm 30"

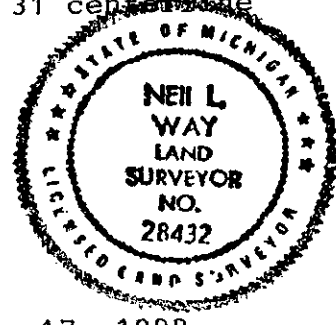

Signed by *Neil L. Way*
Surveyor's Michigan License No. 28432

Date Dec. 17, 1998