

FEB 16 1999

187

Liber 00003 Page 0040

LAND CORNER RECORDATION CERTIFICATE ANTRIM COUNTY MI.
Filing Requirement of Act 74, Mich. P.A. 1970 Register of Deeds
Recorded

SECTION

For corners in

Antrim
(County)

Located in: Elk Corner Code #
Rapids Twp.

12-28-1998 10:19:51

Manda R. Conway
REGISTER OF DEEDS

Register of Deeds Stamp & File Number

- 1. Public Land Survey Sec. 29 T29NR9W E-10
T__R__
T__R__
T__R__
- 2. Property Controlling S__T__R__
in Section S__T__R__
- 3. Miscellaneous S__T__R__
Property in Sec. S__T__R__

- 4. Lot No. _____, Recorded Plat _____
- 5. Private Claims _____

I, Neil L. Way, in a field survey on Dec. 16, 1998, do hereby state that under requirements of P.A. 74, Michigan P.A. of 1970, the corner points mentioned in lines 1 and 2 above were in conformance with regulations and rules therefore as required in the current manual of survey instructions of the United States Department of the Interior, Bureau of Land Management or by a decree of a Court of Law and for that the corner points mentioned in lines 3, 4 and 5 above were in conformance with the rules of the Michigan Board of Land Surveyors or by a Decree of a Court of Law; established, re-established, monumented, recovered, found as expressed below:

NOTE: Not more than 2 corners, all in the same town and range, may be recorded on this certificate.

A	B	C	D	E	F	G	H	I	J	K	L	M
1												
2	6		5		4		3		2		1	
3												
4	7		8		9		10		11		12	
5												
6	18		17		16		15		14		13	
7												
8	19		20		21		22		23		24	
9												
10	30		29		28		27		26		25	
11												
12	31		32		33		34		35		36	
13												

A. Description of original monument and accessories and/or subsequent restoration:

- Dec. 1856- GLO set post in swamp
- Oct. 1890- F. Church used corner, no witnesses

B. Description of corner evidence found and/or method applied in restoring or reestablishing corner:


Found 1" iron pipe

Ratified by peer group
in accordance with
P.O. 345
Antrim Co. Chairman
Arthur L. Lennox
Arthur L. Lennox
Nov. 18, 1998

C. Description of monument for corner and accessories established to perpetuate locating the position of the corner:

Set Antrim County Monument at found 1" iron pipe

- S72°W 64.38' Cedar 2"
- S34°W 88.00' Red Pine 3"
- West 23.10' Fence Corner
- S57°E 79.05' White Pine 10"

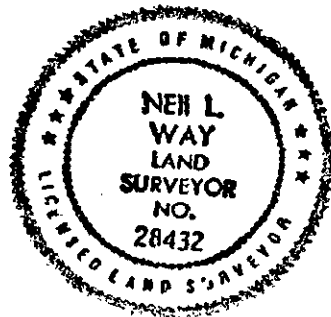

Signed by *Neil L. Way*
Surveyor's Michigan License No. 28432

Date Dec. 17, 1998