

FEB 10 1999

Liber 00003 Page 0036

191

SECTION

LAND CORNER RECORDATION CERTIFICATE
Filing Requirement of Act 74, Mich. P.A. 1970

For corners in

Antrim Located In: Elk Corner Code #
(County) Rapids Twp.

1. Public Land Survey Sec. 33 T29NR9W F-11
 T R
 T R
 T R

2. Property Controlling S T R
 in Section S T R

3. Miscellaneous S T R
 Property in Sec. S T R

ANTRIM COUNTY MI.
Register of Deeds
Recorded

12-28-1998 10:17:17

Wanda R. Conway
REGISTER OF DEEDS

Register of Deeds Stamp & File Number

4. Lot No. _____, Recorded Plat _____
5. Private Claims _____

I, Neil L. Way, in a field survey on Dec. 16, 1998 do hereby state that under requirements of P.A. 74, Michigan P.A. of 1970, the corner points mentioned in lines 1 and 2 above were in conformance with regulations and rules therefore as required in the current manual of survey instructions of the United States Department of the Interior, Bureau of Land Management or by a decree of a Court of Law and /or that the corner points mentioned in lines 3, 4 and 5 above were in conformance with the rules of the Michigan Board of Land Surveyors or by a Decree of a Court of Law; established, re-established, monumented, recovered, found as expressed below:

NOTE: Not more than 2 corners, all in the same town and range, may be recorded on this certificate.

	A	B	C	D	E	F	G	H	I	J	K	L	M
1													
2		6		5		4		3		2		1	
3													
4		7		8		9		10		11		12	
5													
6		18		17		16		15		14		13	
7													
8		19		20		21		22		23		24	
9													
10		30		29		28		27		26		25	
11						●							
12		31		32		33		34		35		36	
13													

A. Description of original monument and accessories and/or subsequent restoration:

- Dec. 1856- GLO set post
- June 1889- F. Church found stake set by Steele (GLO 1856)
- Jan. 1972- C. Ostling found pointed stone presumed to be set by F. Church
- Oct. 1989- B. Jones found pointed stone and set 1/2" iron rod alongside stone

B. Description of corner evidence found and/or method applied in restoring or reestablishing corner:


Found 1/2" iron rod as set by B. Jones alongside stone

Ratified by peer group
in accordance with
P.O. 345
Antrim Co. Chairman
Arthur L. Lennox
Arthur L. Lennox
Nov. 18, 1998

C. Description of monument for corner and accessories established to perpetuate locating the position of the corner:

Set Antrim County Monument at iron rod alongside stone

S23°E 18.08' Poplar 6"
 S35°W 44.10' Poplar 14"
 N73°W 20.20' Poplar 8"
 N40°E 22.66' Poplar 10"

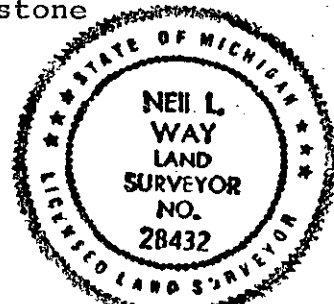

Signed by *Neil L. Way*
Surveyor's Michigan License No. 28432

Date Dec. 17, 1998