SURVEY & REMONUMENTATION

FEB 18 1999

SECTION

154 - 155

Liber 00003 Page 0023

ANTRIM COUNTY MI.
Register of Deeds
Recorded

12-15-1998 10:17:26

Wanda R. Conway
REGISTER OF DEEDS

Register of Deeds Stamp & File Number

LAND CORNER RECORDATION CERTIFICATE
Filing Requirement of Act 74, Mich. P.A. 1970

For corners in

Antrim (County)

Located in: MILTON

Corner Code #

1. Public Land Survey	Sec 35	T29N	R 9W	J-13 ✓
	Sec. 2	T28N	R 9W	J-1
		T___	R___	
		T___	R___	
2. Property Controlling	S___	T___	R___	
in Section	S___	T___	R___	
3. Miscellaneous	S___	T___	R___	
Property in Sec.	S___	T___	R___	

4. Lot No. _____, Recorded Plat _____
5. Private Claims _____

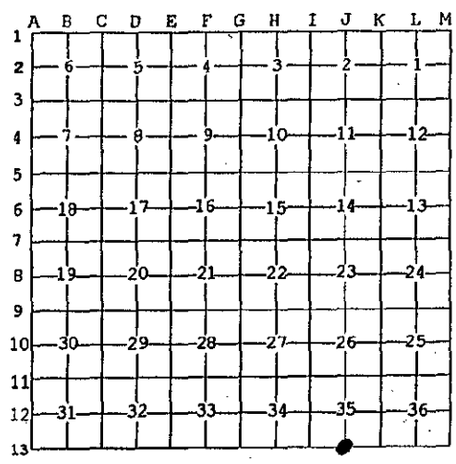

I, Terry B. Smith, in a field survey on 12-10, 19 98 do hereby state that under requirements of P.A. 74, Michigan P.A. of 1970, the corner points mentioned in lines 1 and 2 above were in conformance with regulations and rules therefore as required in the current manual of survey instructions of the United States Department of the Interior, Bureau of Land Management or by a decree of a Court of Law and /or that the corner points mentioned in lines 3, 4 and 5 above were in conformance with the rules of the Michigan Board of Land Surveyors or by a Decree of a Court of Law; established, re-established, monumented, recovered, found as expressed below:

NOTE: Not more than 2 corners, all in the same town and range, may be recorded on this certificate.

A. Description of original monument and accessories and/or subsequent restoration:

GLO Circa 1983 -- no evidence found
certificates: B. Jones 1981
J. Fletcher 1974
Wilcox Assoc 1993
G. DeLaMater 1979
W. Batzer 1977
A. Lennox 1979
LCRC Liber 2 page 161

Ratified by peer group
in accordance with
P.O. 345
Antrim Co. Chairman
Arthur L. Lennox
Nov. 18, 1998

B. Description of corner evidence found and/or method applied in restoring or reestablishing corner:

found ½" steel bar & witnesses per LCRC

C. Description of monument for corner and accessories established to perpetuate locating the position of the corner:

Set Antrim county Monument & highway box
UP N40E 80.71
spk. in basswood clump S15E 30.75
12" Oak S25W 69.96
4" Oak N25W 28.86

STATE OF MICHIGAN
TERRY B. SMITH
LAND SURVEYOR
No. 25873
REGISTERED LAND SURVEYOR

Signed by T.B. Smith

Date DEC. 14, 1998

Surveyor's Michigan License No. 25873

FORM APPROVED BY MICHIGAN STATE BOARD OF PROFESSIONAL SURVEYORS, JAN. 28, 1971
REVISED MAY 14, 1975
REVISED JAN., 1983
REVISED OCT., 1995