

FEB 18 1999

157

Liber 00003 Page 0021

SECTION

LAND CORNER RECORDATION CERTIFICATE  
Filing Requirement of Act 74, Mich. P.A. 1970

ANTRIM COUNTY MI.  
Register of Deeds  
Recorded

For corners in:

Milton

12-15-1998 10:16:24

Wanda R. Conway  
REGISTER OF DEEDS

Register of Deeds Stamp & File Number

Antrim (County)	Located In:	Corner Code #
1. Public Land Survey	Sec. 35 T 29NR 9W	K-11
	T R	
	T R	
	T R	
2. Property Controlling in Section	S T R	
	S T R	
3. Miscellaneous Property in Sec.	S T R	
	S T R	

4. Lot No. \_\_\_\_\_, Recorded Plat \_\_\_\_\_  
5. Private Claims \_\_\_\_\_

I, Terry B. Smith, in a field survey on 12-10-, 19 98 do hereby state that under requirements of P.A. 74, Michigan P.A. of 1970, the corner points mentioned in lines 1 and 2 above were in conformance with regulations and rules therefore as required in the current manual of survey instructions of the United States Department of the Interior, Bureau of Land Management or by a decree of a Court of Law and/or that the corner points mentioned in lines 3, 4 and 5 above were in conformance with the rules of the Michigan Board of Land Surveyors or by a Decree of a Court of Law; established, re-established, monumented, recovered, found as expressed below:

NOTE: Not more than 2 corners, all in the same town and range, may be recorded on this certificate.

	A	B	C	D	E	F	G	H	I	J	K	L	M
1													
2	6		5		4		3		2		1		
3													
4	7		8		9		10		11		12		
5													
6	18		17		16		15		14		13		
7													
8	19		20		21		22		23		24		
9													
10	30		29		28		27		26		25		
11													
12	31		32		33		34		35		36		
13													

A. Description of original monument and accessories and/or subsequent restoration:

GLO post circa 1853  
Antrim county survey records 1901  
Certificates by G. DeLaMater -- 1977  
Certificate by R. Findorff -- 1965  
Certificate by A. Lennox 1993  
Certificate by N. Way -- 1997

Ratified by peer group  
in accordance with  
P.O. 345

Double corners found -- measurements and directions compared with GLO and county records indicate that corner in center line intersection appeared after 1990.


B. Description of corner evidence found and/or method applied in restoring or reestablishing corner:

*Arthur L. Lennox*  
Arthur L. Lennox  
Nov. 18, 1998

At peer group meeting J. Korr stated that his experience indicates F. Church used pipe and his County Surveyor Notes called for a pipe & large stone. Since a pipe was found and was 1.3 feet below the road surface and the distances compared well with prorated GLO measurements that the pipe should be accepted as the best evidence of the perpetuated corner.

C. Description of monument for corner and accessories established to perpetuate locating the position of the corner:

Set Antrim County Monument in Highway box  
1/2" steel bar in center line intersection S69°35'05"E 5.46  
20" Oak N45°W 57.28  
UP N50°W 51.95  
UP N85E 61.53  
6" Cherry S45°E 86.21

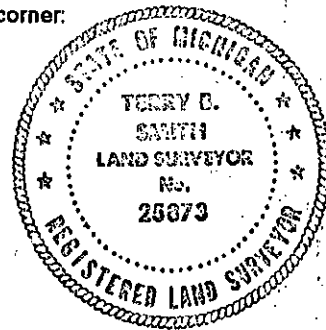

Signed by Terry B. Smith  
Surveyor's Michigan License No. 25873

Date DEC. 14, 1998