

FEB 18 1999

LAND CORNER RECORDATION CERTIFICATE
Filing Requirement of Act 74, Mich. P.A. 1970

ANTRIM COUNTY MI.
Register of Deeds
Recorded

12-15-1998 10:16:02

Wanda R. Conway
REGISTER OF DEEDS

For corners in SECTION

MILTON

Antrim
(County)

Located In:

Corner Code #

1. Public Land Survey	Sec. 35	T 29NR 9W	K-13 ✓
	Sec. 2	T 28NR 9W	K-1
		T ___ R ___	___
		T ___ R ___	___
2. Property Controlling in Section	S ___	T ___ R ___	___
	S ___	T ___ R ___	___
3. Miscellaneous Property in Sec.	S ___	T ___ R ___	___
	S ___	T ___ R ___	___

Register of Deeds Stamp & File Number

4. Lot No. _____, Recorded Plat _____
5. Private Claims _____

I, Terry B. Smith, in a field survey on 12-10, 1998 do hereby state that under requirements of P.A. 74, Michigan P.A. of 1970, the corner points mentioned in lines 1 and 2 above were in conformance with regulations and rules therefore as required in the current manual of survey instructions of the United States Department of the Interior, Bureau of Land Management or by a decree of a Court of Law and /or that the corner points mentioned in lines 3, 4 and 5 above were in conformance with the rules of the Michigan Board of Land Surveyors or by a Decree of a Court of Law; established, re-established, monumented, recovered, found as expressed below:

NOTE: Not more than 2 corners, all in the same town and range, may be recorded on this certificate.

1	A	B	C	D	E	F	G	H	I	J	K	L	M
2		6		5		4		3		2		1	
3													
4		7		8		9		10		11		12	
5													
6		18		17		16		15		14		13	
7													
8		19		20		21		22		23		24	
9													
10		30		29		28		27		26		25	
11													
12		31		32		33		34		35		36	
13													

A. Description of original monument and accessories and/or subsequent restoration:

GLO wood post circa 1853
County Surveyor's notes circa 1901
Certificate N. Way 1998, 1997
certificate B. Jones 1981
certificate James Fletcher 1974
certificate A. Lennox 1978, 1979
LCRC J. Fletcher L. 219 pg. 580

Ratified by peer group
in accordance with
P.O. 345
Antrim Co. Chairman


Arthur L. Lennox
Arthur L. Lennox
Nov. 18, 1998

B. Description of corner evidence found and/or method applied in restoring or reestablishing corner:

found 1/2" steel bar in center line intersection
excavation revealed a "gear shaft" per call of Antrim County Surveyor's notes
circa 1901. Witnesses circa 1901 gone.

C. Description of monument for corner and accessories established to perpetuate locating the position of the corner:

Set Antrim county Monument and highway box
24" Maple S65W 81.10
UP N15W 89.74
UP N51E 43.68
UP S42W 44.28

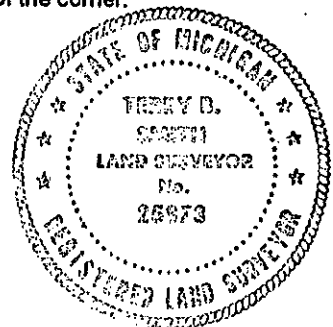

Signed by Terry B. Smith
Surveyor's Michigan License No. 25873

Date DEC 14, 1998