

FEB 18 1999

161-162

Liber 00003 Page 0018
ANTRIM COUNTY MI.
Register of Deeds
Recorded

SECTION

LAND CORNER RECORDATION CERTIFICATE
Filing Requirement of Act 74, Mich. P.A. 1970

For corners in

MILTON

12-15-1998 10:15:52

Manda R. Conway
REGISTER OF DEEDS

Register of Deeds Stamp & File Number

For corners in	Located In:	Corner Code #
<u>Antrim</u> (County)		
1. Public Land Survey	Sec 36 T 29N R 9W	1-13 ✓
	Sec. 1 T 28N R 9W	1-1
	T R	
	T R	
2. Property Controlling in Section	S T R	
	S T R	
3. Miscellaneous Property in Sec.	S T R	
	S T R	

4. Lot No. _____, Recorded Plat _____
5. Private Claims _____

I, Terry B. Smith, in a field survey on 12-10, 1998 do hereby state that under requirements of P.A. 74, Michigan P.A. of 1970, the corner points mentioned in lines 1 and 2 above were in conformance with regulations and rules therefore as required in the current manual of survey instructions of the United States Department of the Interior, Bureau of Land Management or by a decree of a Court of Law and/or that the corner points mentioned in lines 3, 4 and 5 above were in conformance with the rules of the Michigan Board of Land Surveyors or by a Decree of a Court of Law; established, re-established, monumented, recovered, found as expressed below:

NOTE: Not more than 2 corners, all in the same town and range, may be recorded on this certificate.

	A	B	C	D	E	F	G	H	I	J	K	L	M
1													
2	6		5		4		3		2		1		
3													
4	7		8		9		10		11		12		
5													
6	18		17		16		15		14		13		
7													
8	19		20		21		22		23		24		
9													
10	30		29		28		27		26		25		
11													
12	31		32		33		34		35		36		
13													

A. Description of original monument and accessories and/or subsequent restoration:

GLO Set Beech Post circa 1853
County Surveyor's notes 1901
Certificate N. Way 1998, 1997

Ratified by peer group
in accordance with
P.O. 345
Antrim Co. Chairman

Arthur L. Lennox


Arthur L. Lennox
Nov. 18, 1998

B. Description of corner evidence found and/or method applied in restoring or reestablishing corner:

Found $\frac{1}{2}$ " steel rod in center line road & witnesses per certificates

C. Description of monument for corner and accessories established to perpetuate locating the position of the corner:

Set Antrim County Monument and Highway box
12" Apple N20E 51.75
Cable TV Box N45W 50.70
UP S70W 85.70
UP S70E 126.70

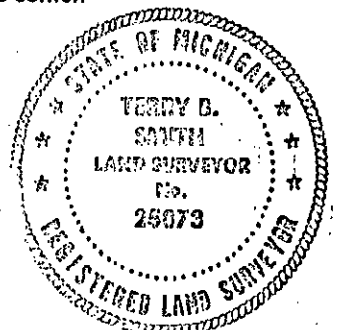

Signed by *Terry B. Smith*
Surveyor's Michigan License No. 25873

Date DEC. 14, 1998