

MICHIGAN  
DEPARTMENT OF CONSERVATION  
FORESTRY DIVISION

# LAND CORNER RECORD


T. 30 N.R. 5W  
T. 30 N.R. 6W Antrim COUNTY

DESCRIPTION OF CORNER Section corner common to Sections 6 - 7 - 1 - 12

CORNER MONUMENT Set 1" pipe with 4" aluminum cap.

DATE MONUMENT PLACED AND WITNESSED 11-20-61

WITNESSES TO CORNER.....

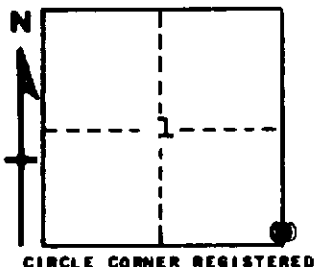

5" Beech	-	N 11 W	-	19.0 feet
7" H. Maple	-	S 2 W	-	16.0 feet
AND				
6" H. Maple	-	N 54 E	-	21.0 feet

DESCRIPTION IN DETAIL AS TO HOW CORNER WAS LOCATED AND IDENTIFIED OR RESTORED.

This corner was restored while making a survey in this area. Set corner to conform to Hebdon's 1877 resurvey of this town line. Set corner by proportionate measurement between good 1/4 corner of 1 - 6 and corner to Sections 13 - 24 - 18 - 19. Corner was also placed to conform to Hebdon's record bearings for this town line. Unable to positively identify any old BT's but this position checks line notes, and falls in line with old grade east.

SURVEYOR'S SEAL

SIGNED *Kenneth J. Ostling* DATE 11/21/61  
REGISTERED LAND SURVEYOR