

FEB 22 1996

COMMISSION

STAR
LAND CORNER RECORDATION CERTIFICATE
Filing Requirement of Act 74, Mich. P.A. 1970

ANTRIM COUNTY
MICHIGAN
RECEIVED FOR RECORD

DEC 6 9 21 AM '95

Washtenaw County
REGISTER OF DEEDS

For corners in
ANTRIM
(County)

Located In: Corner Code #

- 1. Public Land Survey T. 30N R. 5W Corner Code F-3
T. _____ R. _____
T. _____ R. _____
T. _____ R. _____
- 2. Property Controlling S. _____ T. _____ R. _____
in Section S. _____ T. _____ R. _____
- 3. Miscellaneous S. _____ T. _____ R. _____
Property in Sec. S. _____ T. _____ R. _____

Register of Deeds Stamp & File Number

- 4. Lot No. _____, Recorded Plat _____
- 5. Private Claims _____

I, NEILL L. WAY, in a field survey on NOV. 8, 19 95, do hereby certify that under requirements of P.A. 74, Michigan P.A. of 1970, the corner points mentioned in lines 1 and 2 above were in conformance with regulations and rules therefore as required in the current manual of survey instructions of the United States Department of the Interior, Bureau of Land Management or by a decree of a Court of Law and/or that the corner points mentioned in lines 3, 4 and 5 above were in conformance with the rules of the Michigan Board of Land Surveyors or by a Decree of a Court of Law; established, re-established, monumented, re-monumented, recovered, found as expressed below:

NOTE: Not more than 4 corners, all in the same town and range, may be recorded on this certificate.

A. Description of original monument and accessories and/or subsequent restoration:
F-3

GLO SET POST JULY 1839

BEECH 12 S12E 28
BEECH 14 N36W 25


B. Description of corner evidence found and/or method applied in restoring or reestablishing corner:
F-3

NO CORNER OR EVIDENCE FOUND (POTATO FIELD)
RESET CORNER AT MID POINT ON LINE AS ESTABLISHED BY
JONES #23514 2-18-91

C. Description of monument for corner and accessories established to perpetuate locating the position of the corner:
F-3

SET BERSTEN MONUMENT WITH CAP 30 INCHES BELOW SURFACE

Ratified by Peer Group NORTH 50.00' 1/2" IRON ROD
in accordance with SOUTH 50.00' 1/2" IRON ROD
P.O. 345: EAST 2593.42' NE COR SEC 9
Chairman Arthur L. Lennox WEST 2593.42' NW COR SEC 9
Date: Oct. 26, 1995

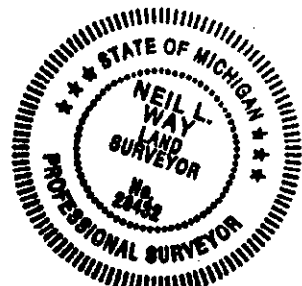

Signed by Neill L. Way Date 12-1-1995

Surveyor's Michigan License No. 28432 LIBER 002 PAGE 278

