

REMONUMENTATION

FEB 22 1995 LAND CORNER RECORDATION CERTIFICATE

ANTRIM COUNTY MICHIGAN RECEIVED FOR RECORD Nov 30 10 49 AM '95

COMMISSION FILING REQUIREMENT OF ACT 74, MICH. P.A. 1970 STAR TWP

Wanda R Conway REGISTER OF DEEDS

Table with 3 columns: FOR CORNERS OF--, LOCATED IN--, CORNER CODE NUMBER. Rows include Public Land Survey, Property Controlling in Section, Miscellaneous Property in Section, Lot No., and Private Claims.

REGISTER OF DEEDS STAMP AND FILING NUMBER

I, Terry B. Smith, do hereby certify that under requirements of P.A. 74, Michigan P.A. of 1970, the corner points mentioned in lines 1 and 2 above were, in a field survey on Oct 26, 1995, established, re-established, monumented, re-monumented, recovered or restored as expressed below and in conformance with regulations and rules therefore as required in the current manual of survey instructions of the United States Department of the Interior, Bureau of Land Management or by a decree of a court of law. Furthermore, that the corner points mentioned in lines 3, 4 and 5 above were, in a field survey on Oct. 26, 1995 found, recovered, restored, established or re-established as expressed below and in conformance with the rules of the Michigan State Board of Registration for Land Surveyors or, by a Decree of a Court of law:

A. Description of original monument and accessories and/or subsequent restoration: GLO 1839 -- established section post @ 79.94 chains Sept. 30, 1975 H. Fluharty set 5/8" re-rod with cap @ intersection of fence and E-W road @ road to south recorded Liber 225 page 90 Antrim County Records.

B. Description of corner evidence found and/or method applied in restoring or re-establishing corner: found 5/8" iron as described replaced with Antrim County Monument

C. Description of monument for corner and accessories established to perpetuate locating the position of the corner: NW Cor. Sec. 11, T30N, R5W set Antrim County Monument 12" Maple N75E 43.25 14" Maple S45E 54.46 16" Maple S30W 42.15 10" Maple S45W 26.90 Ratified by Peer Group in accordance with P.A. 345 Chairman Arthur L. Lennox Date: Oct. 26, 1995


SIGNED BY Terry B. Smith DATE NOV. 29, 1995

SURVEYOR'S MICHIGAN REGISTRATION NO. 25873

FOR STATE AND UNITED STATES AGENCIES:

SIGNED BY CHIEF OF SURVEY PARTY DATE

APPROVED AND SIGNED BY MICHIGAN REGISTERED LAND SURVEYOR DATE

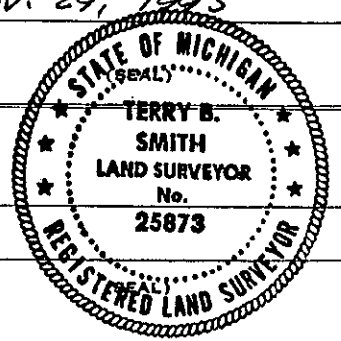

LATE 002 265 SURVEYOR'S MICHIGAN REGISTRATION NO.