

MONUMENTATION

FEB 22 1996

COMMISSION

STAR
LAND CORNER RECORDATION CERTIFICATE
Filing Requirement of Act 74, Mich. P.A. 1970

ANTRIM COUNTY
MICHIGAN
RECEIVED FOR RECORD

Dec 6 9 22 AM '95

Wanda R. Conway
REGISTER OF DEEDS

For corners in
ANTRIM

(County)

Located In:


Corner Code #

- | | | | | | | |
|------------------------------------|---|------------|---|-----------|------------|-------|
| 1. Public Land Survey | T | <u>30N</u> | R | <u>5W</u> | <u>I-5</u> | |
| | T | _____ | R | _____ | _____ | |
| | T | _____ | R | _____ | _____ | |
| | T | _____ | R | _____ | _____ | |
| 2. Property Controlling in Section | S | _____ | T | _____ | R | _____ |
| | S | _____ | T | _____ | R | _____ |
| 3. Miscellaneous Property in Sec. | S | _____ | T | _____ | R | _____ |
| | S | _____ | T | _____ | R | _____ |

Register of Deeds Stamp & File Number

4. Lot No. _____, Recorded Plat _____
5. Private Claims _____

I, NEIL L. WAY, in a field survey on NOV. 8, 19 95, do hereby certify that under requirements of P.A. 74, Michigan P.A. of 1970, the corner points mentioned in lines 1 and 2 above were in conformance with regulations and rules therefore as required in the current manual of survey instructions of the United States Department of the Interior, Bureau of Land Management or by a decree of a Court of Law and/or that the corner points mentioned in lines 3, 4 and 5 above were in conformance with the rules of the Michigan Board of Land Surveyors or by a Decree of a Court of Law; established, re-established, monumented, re-monumented, recovered, found as expressed below:

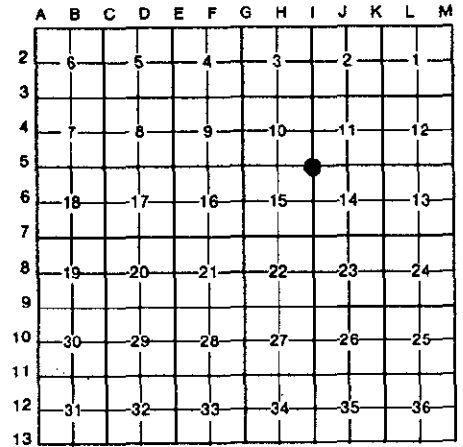

NOTE: Not more than 4 corners, all in the same town and range, may be recorded on this certificate.

A. Description of original monument and accessories and/or subsequent restoration:
I-5

GLO SET POST JULY 1839

HEMLOCK 24 S42E 15

SUGAR 22 S68W 14

FLUHARTY #18223 SET 5\8" RE. ROD IN CENTERLINE ROAD NORTH SOUTH AND ON FENCE LINE TO EAST 9\30\1975.

B. Description of corner evidence found and/or method applied in restoring or reestablishing corner:
I-5

FOUND 5\8" X 18" RE. ROD IN CENTERLINE ROAD NORTH SOUTH AN ON FENCE LINE TO EAST.

C. Description of monument for corner and accessories established to perpetuate locating the position of the corner:
I-5

SET BERSTEN MONUMENT WITH CAP WITH 5\8" IRON BELOW.

Ratified by Peer Group S70E 27.95' MPL 20
in accordance with N04W 51.05' W.CHY 18
P.O. 345: S30W 37.16' W.CHY 6
Chairman Arthur L. Lennox S25E 38.29' MPL 6
Date: Oct. 26, 1995



Signed by Neil L. Way
Surveyor's Michigan License No. 28432

Date 12-1-1995

002 286