

ANTRIM COUNTY  
MICHIGAN  
RECEIVED FOR RECORD  
Nov 30 10 49 AM '95

FEB 22 1996 LAND CORNER RECORDATION CERTIFICATE

FILING REQUIREMENT OF ACT 74, MICH. P.A. 1970  
STAR TWP

COMMISSION

Wanda R. Conway  
REGISTER OF DEEDS

FOR CORNERS OF--:	LOCATED IN--:	CORNER CODE NUMBER
1. PUBLIC LAND SURVEY <u>11</u> T. <u>30</u> N. S., R. <u>5</u> E. W.		<u>J-3</u>
2. PROPERTY CONTROLLING IN SECTION _____, T. _____ N. S., R. _____ E. W.		
3. MISCELLANEOUS PROPERTY IN SECTION _____, T. _____ N. S., R. _____ E. W.		
4. LOT NO. _____, RECORDED PLAT _____		
5. PRIVATE CLAIMS _____		

REGISTER OF DEEDS STAMP AND FILING NUMBER

I, Terry B. Smith, do hereby certify that under requirements of P.A. 74, Michigan P.A. of 1970, the corner points mentioned in lines 1 and 2 above were, in a field survey on Oct 26, 1995, established, re-established, monumented, re-monumented, recovered or restored as expressed below and in conformance with regulations and rules therefore as required in the current manual of survey instructions of the United States Department of the Interior, Bureau of Land Management or by a decree of a court of law. Furthermore, that the corner points mentioned in lines 3, 4 and 5 above were, in a field survey on Oct. 26, 1995 found, recovered, restored, established or re-established as expressed below and in conformance with the rules of the Michigan State Board of Registration for Land Surveyors or, by a Decree of a Court of law:

A. Description of original monument and accessories and/or subsequent restoration:  
GLO 1839 -- established 1/4 section post @ 39.99 chains  
Sept. 30, 1975 H. Fluharty set 5/8" re-rod with cap midway and on line at E-W fence & 20 ft. south of road  
recorded Liber 225 page 90 Antrim County Records.

B. Description of corner evidence found and/or method applied in restoring or re-establishing corner:  
found 5/8" iron as described  
replaced with Antrim County Monument

C. Description of monument for corner and accessories established to perpetuate locating the position of the corner:  
N 1/4 Cor. Sec. 11, T30N, R5W  
set Antrim County Monument  
12" Maple N10W 39.30  
12" Maple N30E 28.55  
8" Beech N80W 19.45  
12" Maple S35E 26.40  
Ratified by Peer Group in accordance with P.A. 345  
Chairman Arthur L. Lennox  
Date: Oct. 26, 1995


SIGNED BY Terry B. Smith DATE Nov. 29, 1995

SURVEYOR'S MICHIGAN REGISTRATION NO. 25873

FOR STATE AND UNITED STATES AGENCIES:

SIGNED BY \_\_\_\_\_ DATE \_\_\_\_\_  
CHIEF OF SURVEY PARTY

APPROVED AND SIGNED BY \_\_\_\_\_ DATE \_\_\_\_\_  
MICHIGAN REGISTERED LAND SURVEYOR

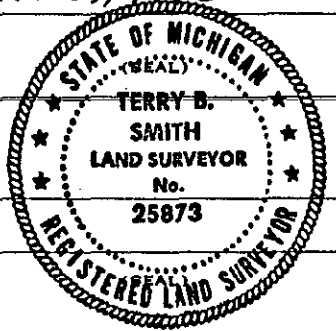

LIBER 002 PAGE 26

SURVEYOR'S MICHIGAN REGISTRATION NO. \_\_\_\_\_