

FEB 22 1996

LAND CORNER RECORDATION CERTIFICATE

COMMISSION FILING REQUIREMENT OF ACT 74, MICH. P.A. 1970

STAR TWP

ANTRIM COUNTY MICHIGAN RECEIVED FOR RECORD Nov 30 10 48 AM '95

Wanda R. Conway REGISTER OF DEEDS

FOR CORNERS OF-- LOCATED IN-- CORNER CODE NUMBER
1. PUBLIC LAND SURVEY 11 T. 30 N. S., R. 5 E. W. J-5
2. PROPERTY CONTROLLING IN SECTION T. N. S., R. E. W.
3. MISCELLANEOUS PROPERTY IN SECTION T. N. S., R. E. W.
4. LOT NO. , RECORDED PLAT
5. PRIVATE CLAIMS

REGISTER OF DEEDS STAMP AND FILING NUMBER

I, Terry B. Smith, do hereby certify that under requirements of P.A. 74, Michigan P.A. of 1970, the corner points mentioned in lines 1 and 2 above were, in a field survey on Oct 26, 1995, established, re-established, monumented, re-monumented, recovered or restored as expressed below and in conformance with regulations and rules therefore as required in the current manual of survey instructions of the United States Department of the Interior, Bureau of Land Management or by a decree of a court of law. Furthermore, that the corner points mentioned in lines 3, 4 and 5 above were, in a field survey on Oct. 26, 1995 found, recovered, restored, established or re-established as expressed below and in conformance with the rules of the Michigan State Board of Registration for Land Surveyors or, by a Decree of a Court of law:

A. Description of original monument and accessories and/or subsequent restoration:

GLO July 2, 1839 -- established 1/2 section post @ 39.91 chains Sept. 30, 1975 H. Fluharty found 3/4" pipe 28" above ground recorded Liber 225 page 90 Antrim County Records.

B. Description of corner evidence found and/or method applied in restoring or re-establishing corner:

Found 3/4" pipe 28" above ground @ approximately 2500 ft. west from SE section corner. Witness in place per 1975 document recorded Liber 225 page 90.

C. Description of monument for corner and accessories established to perpetuate locating the position of the corner:

S 1/2 Cor. Sec. 11, T30N, R5W set Antrim county Monument 5" Maple S34W 23.61 8" Maple S57E 12.10 8" Maple N10W 9.13 10" Maple N65W 15.75

Ratified by Peer Group in accordance with P.A. 345 Chairman Arthur L. Lennox Date: Oct. 26, 1995


SIGNED BY Terry B. Smith DATE NOV. 29, 1995

SURVEYOR'S MICHIGAN REGISTRATION NO. 25873

FOR STATE AND UNITED STATES AGENCIES:

SIGNED BY CHIEF OF SURVEY PARTY DATE

APPROVED AND SIGNED BY MICHIGAN REGISTERED LAND SURVEYOR DATE

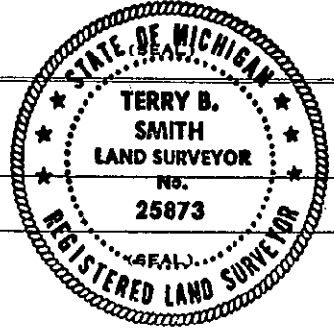

SURVEYOR'S MICHIGAN REGISTRATION NO. 002 1461 263