

MONUMENTATION

ANTRIM COUNTY MICHIGAN RECEIVED FOR RECORD Nov 30 10 49 AM '95

FEB 22 1996

LAND CORNER RECORDATION CERTIFICATE

FILING REQUIREMENT OF ACT 74, MICH. P.A. 1970 STAR TWP.

COMMISSION

Wanda R Conway REGISTER OF DEEDS

FOR CORNERS OF-- LOCATED IN-- CORNER CODE NUMBER
1. PUBLIC LAND SURVEY 12 T. 30 N. 5 R. 5 K-4
2. PROPERTY CONTROLLING IN SECTION T. S. R. E. W.
3. MISCELLANEOUS PROPERTY IN SECTION T. S. R. E. W.
4. LOT NO. RECORDED PLAT
5. PRIVATE CLAIMS

REGISTER OF DEEDS STAMP AND FILING NUMBER

I, Terry B. Smith, do hereby certify that under requirements of P.A. 74, Michigan P.A. of 1970, the corner points mentioned in lines 1 and 2 above were, in a field survey on Oct 26, 1995, established, re-established, monumented, re-monumented, recovered or restored as expressed below and in conformance with regulations and rules therefore as required in the current manual of survey instructions of the United States Department of the Interior, Bureau of Land Management or by a decree of a court of law. Furthermore, that the corner points mentioned in lines 3, 4 and 5 above were, in a field survey on Oct. 26, 1995 found, recovered, restored, established or re-established as expressed below and in conformance with the rules of the Michigan State Board of Registration for Land Surveyors or, by a Decree of a Court of law:

A. Description of original monument and accessories and/or subsequent restoration:

GL0 1839 -- established 1/4 section post @ 40.00 chains Sept. 30, 1975 H. Fluharty set 5/8" re-rod with cap midway and on line recorded Liber 225 page 90 Antrim County Records.

B. Description of corner evidence found and/or method applied in restoring or re-establishing corner:

Corner missing -- reported to Peer Group measured section line and established Antrim county monument midway and on line

C. Description of monument for corner and accessories established to perpetuate locating the position of the corner:

W 1/4 Cor. Sec. 12, T30N, R5W set Antrim County Monument Utility pole N40W 56.30 14" Red Pine S85W 65.30 8" Db1. Cherry S45E 59.90 12" Red Pine N55E 75.95 3 ft. south from center line road to west.

Ratified by Peer Group in accordance with D.A.345 Chairman Arthur L. Lennox Date: Oct. 26, 1995


SIGNED BY Terry B. Smith DATE NOV. 29, 1995

SURVEYOR'S MICHIGAN REGISTRATION NO. 25873

FOR STATE AND UNITED STATES AGENCIES:

SIGNED BY CHIEF OF SURVEY PARTY DATE

APPROVED AND SIGNED BY MICHIGAN REGISTERED LAND SURVEYOR DATE

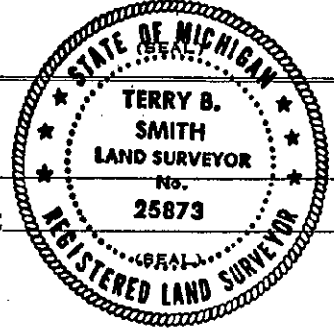

SURVEYOR'S MICHIGAN REGISTRATION NO. 002 263