

MONUMENTATION

FEB 22 1996

# LAND CORNER RECORDATION CERTIFICATE

COMMISSION

FILING REQUIREMENT OF ACT 74, MICH. P.A. 1970

Star Twp.

ANTRIM COUNTY  
MICHIGAN  
RECEIVED FOR RECORD  
Nov 30 10 49 AM '95  
Wade R. Conway  
REGISTER OF DEEDS

FOR CORNERS OF--:	LOCATED IN--:	CORNER CODE NUMBER
1. PUBLIC LAND SURVEY <u>12</u> T. <u>30</u> N. S., R. <u>5</u> E. W.		<u>K-5</u>
2. PROPERTY CONTROLLING IN SECTION _____, T. _____ N. S., R. _____ E. W.		_____
3. MISCELLANEOUS PROPERTY IN SECTION _____, T. _____ N. S., R. _____ E. W.		_____
4. LOT NO. _____, RECORDED PLAT _____		_____
5. PRIVATE CLAIMS _____		_____

REGISTER OF DEEDS STAMP AND FILING NUMBER

I, Terry B. Smith, do hereby certify that under requirements of P.A. 74, Michigan P.A. of 1970, the corner points mentioned in lines 1 and 2 above were, in a field survey on Oct 26, 1995, established, re-established, monumented, re-monumented, recovered or restored as expressed below and in conformance with regulations and rules therefore as required in the current manual of survey instructions of the United States Department of the Interior, Bureau of Land Management or by a decree of a court of law. Furthermore, that the corner points mentioned in lines 3, 4 and 5 above were, in a field survey on Oct. 26, 1995, found, recovered, restored, established or re-established as expressed below and in conformance with the rules of the Michigan State Board of Registration for Land Surveyors or, by a Decree of a Court of law:

A. Description of original monument and accessories and/or subsequent restoration:

GL0 1839 -- established section post @ 79.82 chains  
 Sept. 30, 1975 H. Fluharty found 2 1/2" iron @ intersection of roads to N-S & E  
 recorded Liber 225 page 90 Antrim County Records.

B. Description of corner evidence found and/or method applied in restoring or re-establishing corner:

found 2 1/2" iron as described  
 recommended iron be left in place

C. Description of monument for corner and accessories established to perpetuate locating the position of the corner:


SW Cor. Sec. 12, T30N, R5W  
 2 1/2" narrow gauge RR iron  
 12" Red Pine S75E 59.00  
 24" Maple N40W 65.00  
 Elec. cable box N50W 31.35  
 Utility pole S45E 47.70

Ratified by Peer Group  
 in accordance with P.A. 345  
 Chairman Arthur L. Lennox  
 Date: Oct. 26, 1995

SIGNED BY Terry B. Smith DATE NOV. 29, 1995  
 SURVEYOR'S MICHIGAN REGISTRATION NO. 25873

FOR STATE AND UNITED STATES AGENCIES:

SIGNED BY \_\_\_\_\_ DATE \_\_\_\_\_  
 CHIEF OF SURVEY PARTY  
 APPROVED AND SIGNED BY \_\_\_\_\_ DATE \_\_\_\_\_  
 MICHIGAN REGISTERED LAND SURVEYOR

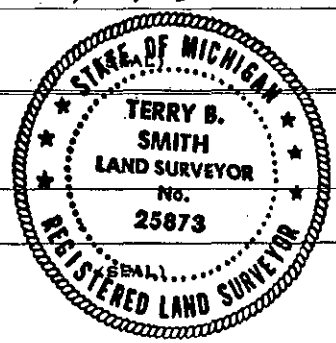

UP 302 268  
 SURVEYOR'S MICHIGAN REGISTRATION NO. \_\_\_\_\_