

MICHIGAN
DEPARTMENT OF CONSERVATION
FORESTRY DIVISION

LAND CORNER RECORD

T. 30 N.R. 6W


Antrim COUNTY

DESCRIPTION OF CORNER Section corner common to Sections 4- 5 - 8 - 9

CORNER MONUMENT Set 1" pipe with 4" Aluminum cap.

DATE MONUMENT PLACED AND WITNESSED 11-20-61

WITNESSES TO CORNER.....

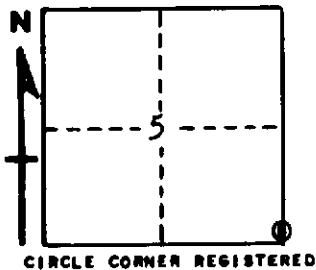

8" Cedar - N 84 W - 17.7 feet

6" Cedar - S 75 E - 25.4 feet

AND
9" Cedar - N 30 E - 12.9 feet

DESCRIPTION IN DETAIL AS TO HOW CORNER WAS LOCATED AND IDENTIFIED OR RESTORED.

This corner was found while making a survey in this township. Found very old stake point in place in swamp at cutting edge, as found and restored by Hebdon in 1877. Stumps of both US.BT's in place and Hebdon's NPT. Old single wire fence north and west from corner. Checks Hebdon's record to stream crossings south, also.

SURVEYOR'S SEAL

SIGNED Kenneth J. Osting DATE 11/21/61
REGISTERED LAND SURVEYOR