

LAND CORNER RECORDATION CERTIFICATE

FILING REQUIREMENT OF ACT 74, MICH. P.A. 1970

FOR CORNERS OF--:	LOCATED IN--:	CORNER CODE NUMBER
1. PUBLIC LAND SURVEY _____	T. <u>30</u> N. <u>6</u> R. <u>6</u> W.	<u>A-4; B-1; E-4</u>
2. PROPERTY CONTROLLING IN SECTION _____	T. _____ N. _____ S. _____ R. _____ E. _____ W. _____	_____
3. MISCELLANEOUS PROPERTY IN SECTION _____	T. _____ N. _____ S. _____ R. _____ E. _____ W. _____	_____
4. LOT NO. _____, RECORDED PLAT _____		
5. PRIVATE CLAIMS _____		

REGISTER OF DEEDS STAMP AND FILING NUMBER

I, Carl F. Roser, do hereby certify that under requirements of P.A. 74, Michigan P.A. of 1970, the corner points mentioned in lines 1 and 2 above were, in a field survey on November 8, 1974, established, re-established, monumented, re-monumented, recovered or restored as expressed below and in conformance with regulations and rules therefore as required in the current manual of survey instructions of the United States Department of the Interior, Bureau of Land Management or by a decree of a court of law. Furthermore, that the corner points mentioned in lines 3, 4 and 5 above were, in a field survey on _____, 19____, found, recovered, restored, established or re-established as expressed below and in conformance with the rules of the Michigan State Board of Registration for Land Surveyors or, by a Decree of a Court of law:

A. Description of original monument and accessories and/or subsequent restoration:

B. Description of corner evidence found and/or method applied in restoring or re-establishing corner:


- A-4 Reestablished ¼ corner in old N-S fence (mostly down) and at prorated distance to Hebden between NW and SW of Section 7.
- B-1 Reestablished N¼ corner (Sec. 6) on third correction line at prorated distance to Hebden's 1877 dependent resurvey between NW and NE of Sec. 6 and on line between the SW and S¼ corners of Sec. 32, T31N, R6W. The corner on third correction line common to Sections 31 & 32, T31N, R6W, is N89°23'W, 358.66 feet.
- E-4 Found 1½" pipe and set Dnr cap on 1" pipe inside same. 1½" pipe was recovered by department in 1961. RLS Bob Findorff also used this corner in 1967.

C. Description of monument for corner and accessories established to perpetuate locating the position of the corner:

A-4	B-1	E-4
Set Dnr monument & cedar post	Set DNR monument & cedar post	DNR monument & cedar post
16" Maple N17°E 42.0	5" Maple S31°E 55.1	20" Maple S61°E 60.5
12" Maple S28°E 12.9	7" W. Pine S11°E 32.2	9" Maple N65°E 60.2
10" Maple S77°W 15.0	6" Cedar S43°W 32.7	8" B. Cherry N21°W 87.8
	10" W. Pine N12°W 47.3	Center E-W Co. Rd. Due N 10'
	E-W rand. Due S 53'	

SIGNED BY Carl F. Roser 9-15-76 DATE _____

SURVEYOR'S MICHIGAN REGISTRATION NO. 12028

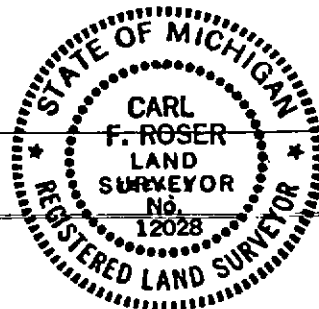

FOR STATE AND UNITED STATES AGENCIES:

SIGNED BY _____ DATE _____

CHIEF OF SURVEY PARTY

APPROVED AND SIGNED BY _____ DATE _____

MICHIGAN REGISTERED LAND SURVEYOR

(SEAL)

SURVEYOR'S MICHIGAN REGISTRATION NO. _____

CHESTONIA TOWNSHIP
ANTRIM COUNTY