

LAND CORNER RECORDATION CERTIFICATE

FILING REQUIREMENT OF ACT 74, MICH. P.A.1970

FOR CORNERS OF--:	LOCATED IN--:	CORNER CODE NUMBER
1. PUBLIC LAND SURVEY _____	T. <u>30</u> N. <u>6</u> R. <u>6</u> W.	A-2; C-1; C-2
2. PROPERTY CONTROLLING IN SECTION _____	T. _____ N. _____ R. _____ E. _____ W. _____	_____
3. MISCELLANEOUS PROPERTY IN SECTION _____	T. _____ N. _____ R. _____ E. _____ W. _____	_____
4. LOT NO. _____, RECORDED PLAT _____		
5. PRIVATE CLAIMS _____		

REGISTER OF DEEDS STAMP AND FILING NUMBER


I, Carl F. Roser, do hereby certify that under requirements of P.A. 74, Michigan P.A. of 1970, the corner points mentioned in lines 1 and 2 above were, in a field survey on June 2, 1975, established, re-established, monumented, re-monumented, recovered or restored as expressed below and in conformance with regulations and rules therefore as required in the current manual of survey instructions of the United States Department of the Interior, Bureau of Land Management or by a decree of a court of law. Furthermore, that the corner points mentioned in lines 3, 4 and 5 above were, in a field survey on _____, 19____, found, recovered, restored, established or re-established as expressed below and in conformance with the rules of the Michigan State Board of Registration for Land Surveyors or, by a Decree of a Court of law:

- A. Description of original monument and accessories and/or subsequent restoration:
- B. Description of corner evidence found and/or method applied in restoring or re-establishing corner:
- A-2 Reestablished 1/4 corner on line and at prorated distance to Hebden between NW and SW of Section 6.
 - C-1 Reestablished corner common to Sections 5 & 6, T30N, R6W, on third correction line, at prorated distance to Hebden's dependent resurvey of 1877 between NW Sec. 6 and NE Sec. 5 and on line between the SW and SE of Sec. 32, T31N, R6W. The S 1/4 corner of Sec. 32, T31N, R6W, is N89°23'W, 340.94'.
 - C-2 Reestablished 1/4 corner on line and at prorated distance to Hebden between section corners to north and south.
- C. Description of monument for corner and accessories established to perpetuate locating the position of the corner:

A-2	C-1	C-2
Set DNR mon. & cedar post	Set DNR mon. & cedar post	Set DNR mon. & cedar post
12" Maple S45°E 18.3	22" W. Pine N22°W 42.0	5" Cedar N48°E 26.3
5" Ironwood N56°W 12.6	24" W. Pine N59°E 34.7	7" Cedar S35°E 36.0
7" Maple N82°E 36.2	11" B. Cherry S09°W 89.7	8" Hemlock S01°W 25.5
7" Maple S46°W 56.7	5" Maple S79°W 35.6	9" Cedar S87°W 36.6
Old N-S w.wire fence	E-W Rand. Due S 25'	E-W fence Due N 28'
Due E 22.5		

SIGNED BY Carl F. Roser 9-15-76 DATE _____

SURVEYOR'S MICHIGAN REGISTRATION NO. 12028

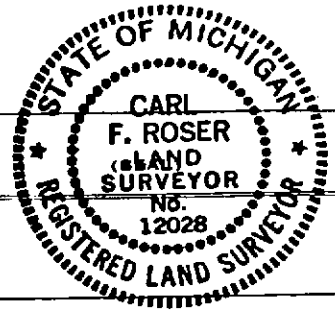

FOR STATE AND UNITED STATES AGENCIES:

SIGNED BY _____ DATE _____

CHIEF OF SURVEY PARTY

APPROVED AND SIGNED BY _____ DATE _____

MICHIGAN REGISTERED LAND SURVEYOR (SEAL)

CHESTONIA TOWNSHIP
ANTRIM COUNTY

SURVEYOR'S MICHIGAN REGISTRATION NO. _____