

LAND CORNER RECORDATION CERTIFICATE

FILING REQUIREMENT OF ACT 74, MICH. P.A.1970

FOR CORNERS OF --	LOCATED IN --	CORNER CODE NUMBER
1. PUBLIC LAND SURVEY _____	T. 30 N. R. 6 W.	C-3; C-4; D-3; D-4
2. PROPERTY CONTROLLING IN SECTION _____	T. _____ N. S. R. _____ E. W.	_____
3. MISCELLANEOUS PROPERTY IN SECTION _____	T. _____ N. S. R. _____ E. W.	_____
4. LOT NO. _____, RECORDED PLAT _____		
5. PRIVATE CLAIMS _____		

REGISTER OF DEEDS STAMP AND FILING NUMBER

I, Carl F. Roser, do hereby certify that under requirements of P.A. 74, Michigan P.A. of 1970, the corner points mentioned in lines 1 and 2 above were, in a field survey on June 2, 1975, established, re-established, monumented, re-monumented, recovered or restored as expressed below and in conformance with regulations and rules therefore as required in the current manual of survey instructions of the United States Department of the Interior, Bureau of Land Management or by a decree of a court of law. Furthermore, that the corner points mentioned in lines 3, 4 and 5 above were, in a field survey on _____, 19____, found, recovered, restored, established or re-established as expressed below and in conformance with the rules of the Michigan State Board of Registration for Land Surveyors or, by a Decree of a Court of law:

~~A. Description of original monument and accessories and/or subsequent restoration:~~

C. (continued)

D-4

Found 1" pipe in road (3/4" rod is 33.0' N)
 Power Pole N58°E 36.36
 6" Cedar N23°W 44.00
 6" Cedar S10°W 40.83
 On Center E-W gravel county road
 Set cedar post w/loc. tag Due N 33'

B. Description of corner evidence found and/or method applied in restoring or re-establishing corner:

- C-3 Found 3/4" rod by RLS Bob Findorff & set DNR mon. at this position; fits Hebden survey of north line of Sec. 8.
- C-4 Reestablished west 1/4 corner of Sec. 8 at double-distance and across the recovered center of Sec. and west 1/8 corner on E-W 1/4 line of Sec. 8; this fits survey by RLS Findorff, '67.
- D-3 Dept. monument as set in 1961 at position of recovered corner & standing Hebden 1877 witness NE (cedar showing good upper face) and hemlock stump SW.
- D-4 Found and accepted 1" pipe as recovered and accepted by RLS Findorff in 1967. Corner believed to be a result of old Botsford survey.

C. Description of monument for corner and accessories established to perpetuate locating the position of the corner:

C-3	C-4	D-3
Set DNR mon. & cedar post	Set DNR mon. & cedar post	Found DNR mon. & cedar post
26" Hemlock N11°E 157.5	14" B.Cherry S71°E 22.0	10" Cedar N02°E 17.0
18" Hemlock S56°E 98.9	12" Twn.Maple S23°E 27.8	11" Cedar N35°E 3.0
8" Elm S03°W 56.5	14" Maple S48°W 51.1	9" Cedar S13°W 28.6
	16" Maple S88°W 54.4	8" Cedar N89°W 14.9


SIGNED BY Carl F. Roser 9-15-76 DATE _____

SURVEYOR'S MICHIGAN REGISTRATION NO. 12028

FOR STATE AND UNITED STATES AGENCIES:

SIGNED BY _____ DATE _____

APPROVED AND SIGNED BY _____ DATE _____

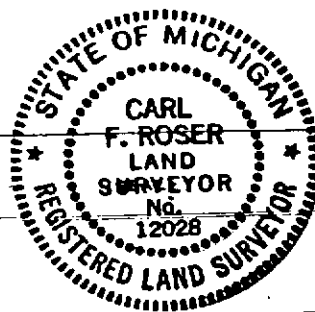

CHESTONIA TOWNSHIP
ANTRIM COUNTY

SURVEYOR'S MICHIGAN REGISTRATION NO. _____