

# LAND CORNER RECORDATION CERTIFICATE

## FILING REQUIREMENT OF ACT 74, MICH. P.A. 1970

FOR CORNERS OF --:	LOCATED IN --:	CORNER CODE NUMBER
1. PUBLIC LAND SURVEY _____	T. <u>30</u> N. <u>6</u> R. <u>6</u> W.	D-1; E-1; E-2
2. PROPERTY CONTROLLING IN SECTION _____	T. _____ N. _____ S. _____ R. _____ E. _____ W. _____	_____
3. MISCELLANEOUS PROPERTY IN SECTION _____	T. _____ N. _____ S. _____ R. _____ E. _____ W. _____	_____
4. LOT NO. _____, RECORDED PLAT _____		
5. PRIVATE CLAIMS _____		

REGISTER OF DEEDS STAMP AND FILING NUMBER

I, Carl F. Roser, do hereby certify that under requirements of P.A. 74, Michigan P.A. of 1970, the corner points mentioned in lines 1 and 2 above were, in a field survey on October 17, 1974, established, re-established, monumented, re-monumented, recovered or restored as expressed below and in conformance with regulations and rules therefore as required in the current manual of survey instructions of the United States Department of the Interior, Bureau of Land Management or by a decree of a court of law. Furthermore, that the corner points mentioned in lines 3, 4 and 5 above were, in a field survey on \_\_\_\_\_, 19\_\_\_\_, found, recovered, restored, established or re-established as expressed below and in conformance with the rules of the Michigan State Board of Registration for Land Surveyors or, by a Decree of a Court of law:

~~A. Description of original monument and accessories and/or subsequent restoration:~~

B. (continued)

E-2 Reestablished  $\frac{1}{4}$  corner on line and prorated to Hebden 1877 resurvey between NE and SE of Sec. 5

B. Description of corner evidence found and/or method applied in restoring or re-establishing corner:

D-1 Reestablished  $\frac{1}{4}$  corner (Sec. 5) on third correction line at prorated distance to Hebden's 1877 dependent resurvey between the NE and NW of Sec. 5 and on line between the SW and S $\frac{1}{4}$  corners of Sec. 33, T31N, R6W. The corner on third correction line common to Sections 32 & 33, T31N, R6W, is N89°48'30"W, 323.22'.

E-1 Restored sec. corner common to Sec. 4 & 5, T30N, R6W, on third correction line or on line between the S $\frac{1}{4}$  & SE corners of Sec. 33, T31N, R6W & at the departure of found 1 $\frac{1}{2}$ " pipe, that is due N, 110.5'. The corner restored by this method fits Hebden distance  $\frac{1}{2}$  mile within 4' & data on previous dept. survey from 1962. The S $\frac{1}{4}$  corner of sec. 33 T31N, R6W, is N89°48'30"W, 331.86'.

C. Description of monument for corner and accessories established to perpetuate locating the position of the corner:

D-1	E-1	E-2
Set DNR mon. & cedar post	Set DNR mon. & cedar post	Set DNR mon. & cedar post
9" Maple Due S 24.0	5" Maple N20°W 31.6	11" B. Cherry N82°E 44.4
12" B. Cherry N67°W 36.5	8" Maple N77°W 43.4	10" Ironwood N27°W 44.4
7" Maple N40°E 39.6	6" Maple S33°E 33.3	9" Maple N87°W 14.2
Center N-S Dirt Rd.	on E-W random	16" W. Pine S26°W 95.5
Due W 88'		N-S random Due W 1.1
on E-W random line		


SIGNED BY Carl F. Roser 9-15-76 DATE \_\_\_\_\_

SURVEYOR'S MICHIGAN REGISTRATION NO. 12028

FOR STATE AND UNITED STATES AGENCIES:

SIGNED BY \_\_\_\_\_ DATE \_\_\_\_\_

APPROVED AND SIGNED BY \_\_\_\_\_ DATE \_\_\_\_\_

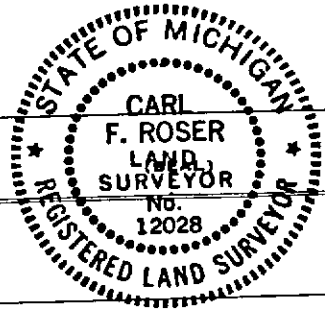

CHESTONIA TOWNSHIP  
ANTRIM COUNTY

SURVEYOR'S MICHIGAN REGISTRATION NO. \_\_\_\_\_