LAND CORNER RECORDATION CERTIFICATE

Filing Requirement of Act 74, Mich. P.A. 1970

For corners in ANTRIM (County)

	Located In:	Corner Code #1
1. Public Land Survey	T 30N R 6W	D-2
	T ___ R ___	
	T ___ R ___	
	T ___ R ___	
2. Property Controlling	S 5 T ___ R ___	9
in Section	S ___ T ___ R ___	
3. Miscellaneous	S ___ T ___ R ___	
Property in Sec.	S ___ T ___ R ___	

Register of Deeds Stamp & File Number

4. Lot No. _____ , Recorded Plat _____
5. Private Claims _____

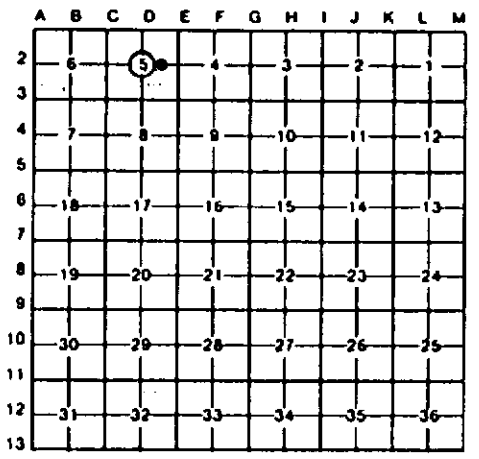

I, C.F.ROSER, in a field survey on 6-27, 19 90, do hereby certify that under requirements of P.A. 74, Michigan P.A. of 1970, the corner points mentioned in lines 1 and 2 above were in conformance with regulations and rules therefore as required in the current manual of survey instructions of the United States Department of the Interior, Bureau of Land Management or by a decree of a Court of Law and/or that the corner points mentioned in lines 3, 4 and 5 above were in conformance with the rules of the Michigan Board of Land Surveyors or by a Decree of a Court of Law; established, re-established, monumented, re-monumented, recovered, found as expressed below:

NOTE: Not more than 4 corners, all in the same town and range, may be recorded on this certificate.

A. Description of original monument and accessories and/or subsequent restoration:

D-2 9

(NO EVIDENCE OF G.L.O. CORNER, B.T'S, LINE TREES & TOPOGRAPHY, AS CALLED OUT IN THE G.L.O. LINE NOTES; UNLESS NOTED IN ITEM "B" BELOW.)

B. Description of corner evidence found and/or method applied in restoring or reestablishing corner:

D-2	9
ESTABLISHED TRUE CENTER OF SEC. 5 AT INTERSECTION OF ONE-QUARTER LINES. EASTERLY EDGE OF JORDAN RIVER IS WEST, 10'±.	ESTAB. E1/8 COR ON E-W 1/4 LINE OF SEC. 5, EQUDISTANT AND ON LINE BETWEEN CTR. & E1/4 COR'S OF SEC. 5.

C. Description of monument for corner and accessories established to perpetuate locating the position of the corner:

D-2

DROVE 1"x 5' GALV. PIPE W/PS CAP & SET CED. POST W/LOC TAG.

5"TAMARACK	N25°W	21.7'
6" CEDAR	N80°E	26.6'
5" CEDAR	S30°E	30.0'
8" CEDAR	S40°W	8.5'

9

DROVE 5/8"x 34" REROD W/PS CAP & SET CEDAR POST W/LOC TAG.

3"IRONWOOD	N40°E	2.6'
12"S.MAPLE	S10°E	31.8'
10" ASH	S55°W	15.4'

FD 1/2" REROD FOR NE COR LOT "D" N02°28'W 83.29'
DROVE 1/2"x 18" REROD ON E. LINE OF LOT "D" S89°10'W 5.09'

STATE OF MICHIGAN
CARL F. ROSER
LAND SURVEYOR
No. 12028
REGISTERED LAND SURVEYOR

Signed by Carl F. Roser Date 6-27-90

Surveyor's Michigan License No. 12028

FORM APPROVED BY MICHIGAN STATE BOARD OF LAND SURVEYORS, JAN. 28, 1971
REVISED MAY 14, 1975
REVISED JAN., 1983