

LAND CORNER RECORDATION CERTIFICATE

FILING REQUIREMENT OF ACT 74, MICH. P.A.1970

FOR CORNERS OF --:	LOCATED IN --:	CORNER CODE NUMBER
1. PUBLIC LAND SURVEY _____	T. 30 N. R. 7 W. ●	H-3
2. PROPERTY CONTROLLING IN SECTION 3 _____	T. 30 N. R. 7 W. ●	3; 10
3. MISCELLANEOUS PROPERTY IN SECTION _____	T. _____ N. S., R. _____ E. W.	
4. LOT NO. _____, RECORDED PLAT _____		
5. PRIVATE CLAIMS _____		

REGISTER OF DEEDS STAMP AND FILING NUMBER

I, Carl F. Roser, do hereby certify that under requirements of P.A. 74, Michigan P.A. of 1970, the corner points mentioned in lines 1 and 2 above were, in a field survey on July 22, 1976, established, re-established, monumented, re-monumented, recovered or restored as expressed below and in conformance with regulations and rules therefore as required in the current manual of survey instructions of the United States Department of the Interior, Bureau of Land Management or by a decree of a court of law. Furthermore, that the corner points mentioned in lines 3, 4 and 5 above were, in a field survey on _____, 19____, found, recovered, restored, established or re-established as expressed below and in conformance with the rules of the Michigan State Board of Registration for Land Surveyors or, by a Decree of a Court of law:

A. Description of original monument and accessories and/or subsequent restoration:

B. Description of corner evidence found and/or method applied in restoring or re-establishing corner:

- H-3 Found 1½" iron pin in S edge of old narrow road grade, in curve, & in line with fences to N & S. Corner fits survey of Sec. 3 by F. Church, 1909 & 1911.
- 3 Restored N 1/16 corner on W line of Sec. 3 T30N-R7W, at prorated distance to F.S. Church between section corner N & ¼ corner S & on line between same.
- 10 Restored S 1/16 corner on W line Sec. 3, T30N-R7W equidistant & on line between section corner S & ¼ corner N. Corner is in line with old fences to E & W; is 10'± E of old N-S township road grade & fits F.S. Church survey of Sec. 3, 1909 & 1911.

C. Description of monument for corner and accessories established to perpetuate locating the position of the corner:

	3	10
Found 1½" iron pin (buried 0.5')	Set 1"x36" pipe & cedar post w/loc. tag	Set 1"x36" pipe & cedar post w/loc. tag
16" Hemlock S63°W 54.50	12" Maple S35°W 13.8	14" Maple N29°E 22.22
15" Maple S69°E 31.31	12" Maple S08°E 29.8	12" Maple S30°W 53.57
Cor.Fn.Post South 23'	7" Maple S75°E 7.7	14" Maple S78°W 27.34
Cor.Fn.Post North 25'	7" Maple N09°E 30.4	
Set cedar post w/loc. tag Due N 33'	N-S Random Due W 13'±	


SIGNED BY Carl F. Roser 9-15-76 DATE

SURVEYOR'S MICHIGAN REGISTRATION NO. 12028

FOR STATE AND UNITED STATES AGENCIES:

SIGNED BY _____ DATE _____

APPROVED AND SIGNED BY _____ DATE _____

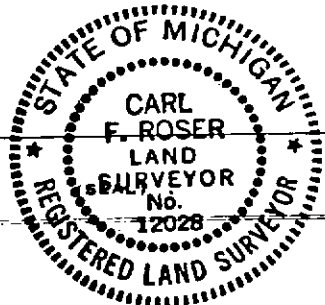

KEARNEY TOWNSHIP
ANTRIM COUNTY

SURVEYOR'S MICHIGAN REGISTRATION NO. _____