

LAND CORNER RECORDATION CERTIFICATE

FILING REQUIREMENT OF ACT 74, MICH. P.A.1970

FOR CORNERS OF --:	LOCATED IN --:	CORNER CODE NUMBER
1. PUBLIC LAND SURVEY _____	T. 30 N. R. 7 W. <input checked="" type="radio"/>	I-1; L-1
2. PROPERTY CONTROLLING IN SECTION _____	T. _____ N. S., R. _____ E. W. _____	_____
3. MISCELLANEOUS PROPERTY IN SECTION _____	T. _____ N. S., R. _____ E. W. _____	_____
4. LOT NO. _____, RECORDED PLAT _____		
5. PRIVATE CLAIMS _____		

REGISTER OF DEEDS STAMP AND FILING NUMBER

I, Carl F. Roser, do hereby certify that under requirements of P.A. 74, Michigan P.A. of 1970, the corner points mentioned in lines 1 and 2 above were, in a field survey on October 28, 1975, established, re-established, monumented, re-monumented, recovered or restored as expressed below and in conformance with regulations and rules therefore as required in the current manual of survey instructions of the United States Department of the Interior, Bureau of Land Management or by a decree of a court of law. Furthermore, that the corner points mentioned in lines 3, 4 and 5 above were, in a field survey on _____, 19____, found, recovered, restored, established or re-established as expressed below and in conformance with the rules of the Michigan State Board of Registration for Land Surveyors or, by a Decree of a Court of law:

A. Description of original monument and accessories and/or subsequent restoration:

B. Description of corner evidence found and/or method applied in restoring or re-establishing corner:


- I-1 Recovered F. Church's stake & witnesses for NE corner of Sec. 3, T. 30 N., R. 7 W., per his survey of Sec. 3 of record, dated 1909 & 1911, & his survey of Sec. 35, T. 31 N., R. 7 W., dated 1887 & 1888. Church had original U.S. corner here. The S $\frac{1}{4}$ corner of Sec. 35, T. 31 N., R. 7 W. (on third correction line) is S87°40'E, 201.27'. Note: Church's survey notes are on record at Antrim County Register of Deeds.
- L-1 Reestablished N $\frac{1}{4}$ corner, Sec. 1 (on third correction line) on line between the SE & SW corners of Sec. 36, T. 31 N., R. 7 W., and equidistant between the NE & NW corners of Sec. 1. The corner on third correction line common to Sec. 36 (T31N-R7W) & Sec. 31 (T31N-R6W) is S86°18'23.05'.

C. Description of monument for corner and accessories established to perpetuate locating the position of the corner:

I-1	L-1
Found stake & set DNR mon. & cedar post	Set DNR mon. & cedar post in NE'ly edge of hayfield
9" W. Pine S70°E 4.5	Ctr. of 4'x4'x2 $\frac{1}{2}$ ' high black rock
8" W. Pine N33°W 15.5	N73°E 16.0
10" W. Pine N88°W 32.9	5" Cedar N70°E 102.8
7" W. Pine N32°E 19.7	10" Twn.Apple S79°E 160.6
	12" Rock Elm N44°W 57.7

SIGNED BY Carl F. Roser 9-15-76 DATE _____

SURVEYOR'S MICHIGAN REGISTRATION NO. 12028

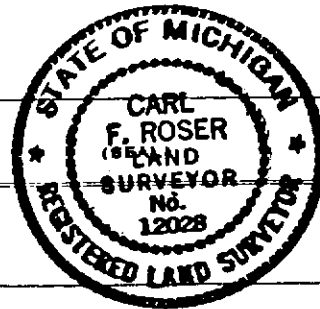

FOR STATE AND UNITED STATES AGENCIES:

SIGNED BY _____ DATE _____
CHIEF OF SURVEY PARTY

APPROVED AND SIGNED BY _____ DATE _____
MICHIGAN REGISTERED LAND SURVEYOR

(SEAL)

SURVEYOR'S MICHIGAN REGISTRATION NO. _____ KEARNEY TOWNSHIP
ANTRIM COUNTY