

**SURVEY &  
REMONUMENTATION**

ANTRIM COUNTY  
MICHIGAN  
RECEIVED FOR RECORD

93 DEC 13 AM 9:32

*Wanda R. Conway*  
REGISTER OF DEEDS

REF 002 Abt 175

FEB 17 1994

**COMMISSION  
LAND CORNER RECORDATION CERTIFICATE**

Filing Requirement of Act 74, Mich. P.A. 1970

For corners in  
**ANTRIM**

(County)

Located In: \_\_\_\_\_ Corner Code # \_\_\_\_\_

- |                                    |                          |       |
|------------------------------------|--------------------------|-------|
| 1. Public Land Survey              | T <u>30N</u> R <u>7W</u> | A-5   |
|                                    | T _____ R _____          | _____ |
|                                    | T _____ R _____          | _____ |
|                                    | T _____ R _____          | _____ |
| 2. Property Controlling in Section | S _____ T _____ R _____  | _____ |
|                                    | S _____ T _____ R _____  | _____ |
| 3. Miscellaneous Property in Sec.  | S _____ T _____ R _____  | _____ |
|                                    | S _____ T _____ R _____  | _____ |

Register of Deeds Stamp & File Number

4. Lot No. \_\_\_\_\_, Recorded Plat \_\_\_\_\_
5. Private Claims \_\_\_\_\_

	A	B	C	D	E	F	G	H	I	J	K	L	M
2	6		5		4		3		2		1		
3													
4	7		8		9		10		11		12		
5													
6	18		17		16		15		14		13		
7													
8	19		20		21		22		23		24		
9													
10	30		29		28		27		26		25		
11													
12	31		32		33		34		35		36		
13													

I, NEIL L. WAY, in a field survey on DEC 10, 1993, 19\_\_\_\_, do hereby certify that under requirements of P.A. 74, Michigan P.A. of 1970, the corner points mentioned in lines 1 and 2 above were in conformance with regulations and rules therefore as required in the current manual of survey instructions of the United States Department of the Interior, Bureau of Land Management or by a decree of a Court of Law and/or that the corner points mentioned in lines 3, 4 and 5 above were in conformance with the rules of the Michigan Board of Land Surveyors or by a Decree of a Court of Law; established, re-established, monumented, re-monumented, recovered, found as expressed below:

**NOTE: Not more than 4 corners, all in the same town and range, may be recorded on this certificate.**

A. Description of original monument and accessories and/or subsequent restoration:

**A-5 NW COR SEC 18**

GLO SET COR  
HEMLOCK 24 S30W 41L  
CEDAR 14 N43W 11L  
HEMLOCK 10 N57E 15L  
CEDAR 10 S54E 33L

B. Description of corner evidence found and/or method applied in restoring or reestablishing corner:


**FOUND 1 1/4" IRON PIPE AND WIT'S AS SHOWN RECENT SURVEYS AND RECORDED IN COUNTY RECORDS.**

C. Description of monument for corner and accessories established to perpetuate locating the position of the corner:

**A-5 NW COR SEC 18**

**REPLACED 1 1/4" IRON WITH ANTRIM COUNTY MONUMENT.**

N22E 7.83' SPK FND 14" CEDAR  
N48W 12.20' SPK FND 8" MPL  
N76W 31.50' SPK FND 14" Y. BIRCH  
S05W 74.12' NW COR HOUSE FND.

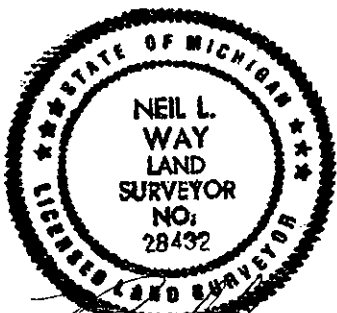

Signed by *Neil L. Way*  
Surveyor's Michigan License No. 28432

Date DEC 10, 1993