

SURVEY & RECORDS
RECORDATION

ANTRIM COUNTY
MICHIGAN
RECEIVED FOR RECORD

93 DEC 13 AM 9:32

FEB 17 1994

COMMISSION
LAND CORNER RECORDATION CERTIFICATE

Filing Requirement of Act 74, Mich. P.A. 1970

Wanda R. Lawson
REGISTER OF DEEDS

For corners in
ANTRIM

(County)

Located In: Corner Code #

- | | | | | | |
|------------------------------------|---|-----|---|----|-----|
| 1. Public Land Survey | T | 30N | R | 7W | A-6 |
| | T | | R | | |
| | T | | R | | |
| | T | | R | | |
| 2. Property Controlling in Section | S | | T | R | |
| | S | | T | R | |
| 3. Miscellaneous Property in Sec. | S | | T | R | |
| | S | | T | R | |

Register of Deeds Stamp & File Number

4. Lot No. _____, Recorded Plat _____
5. Private Claims _____

	A	B	C	D	E	F	G	H	I	J	K	L	M
2	6		5		4		3		2		1		
3													
4	7		8		9		10		11		12		
5													
6	18		17		16		15		14		13		
7													
8	19		20		21		22		23		24		
9													
10	30		29		28		27		26		25		
11													
12	31		32		33		34		35		36		
13													

I, NEIL L. WAY, in a field survey on DEC 10, 1993, 19____,

do hereby certify that under requirements of P.A. 74, Michigan P.A. of 1970, the corner points mentioned in lines 1 and 2 above were in conformance with regulations and rules therefore as required in the current manual of survey instructions of the United States Department of the Interior, Bureau of Land Management or by a decree of a Court of Law and/or that the corner points mentioned in lines 3, 4 and 5 above were in conformance with the rules of the Michigan Board of Land Surveyors or by a Decree of a Court of Law; established, re-established, monumented, re-monumented, recovered, found as expressed below:

NOTE: Not more than 4 corners, all in the same town and range, may be recorded on this certificate.

A. Description of original monument and accessories and/or subsequent restoration:

A-6 W 1/4 COR SEC 18

GLO SET COR
HEMLOCK 9 S78W 4L
SUGAR 16 N53E 32L

NO EVIDENCE FOUND

F. CHURCH FND OLD STK STUMP OF
SUGAR 16 N53E 32L
MARKED ELM 14 S21E 57 1/2 L ON
MAY 2, 1893

NO EVIDENCE FOUND

B. Description of corner evidence found and/or method applied in restoring or reestablishing corner:

A-6 W 1/4 COR SEC 18


FOUND 1 1/4" X 36" COUNTY IRON (CAP MISSING) AS SHOWN ON SURVEY BY FRANK D. AUSTIN L.S. AND RECORDED IN COUNTY RECORDS AUG 31, 1962. AND RETRACED BY ARTHUR LENNOX JAN 29, 1987. ACCEPTED THIS AS TRUE 1/4 COR.

C. Description of monument for corner and accessories established to perpetuate locating the position of the corner:

A-6 W 1/4 COR SEC 18

REPLACED 1 1/4" IRON WITH ANTRIM COUNTY MONUMENT

S10W 25.25' SPK SET 10" SCOTCH PINE
N86E 42.00' SPK SET 14" SCOTCH PINE
N29W 41.42' SPK SET 10" SCOTCH PINE
N27E 15.50' SPK SET P. POLE

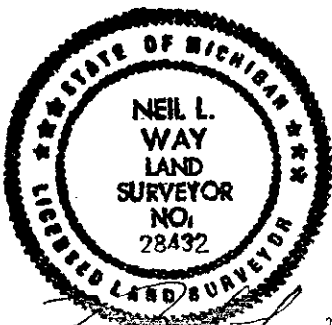

Signed by Neil L. Way
Surveyor's Michigan License No. 28432

Date DEC 10, 1993