

SURVEY & REMONUMENTATION LAND CORNER RECORDATION CERTIFICATE

APR 26 1995 FILING REQUIREMENT OF ACT 74, MICH. P.A.1970

COMMISSION

FOR CORNERS OF--:	LOCATED IN--:	CORNER CODE NUMBER
1. PUBLIC LAND SURVEY <u>29</u> T. <u>30</u> ^{N.} _{S.} , R. <u>7</u> ^{E.} _{W.}		C-11
2. PROPERTY CONTROLLING IN SECTION _____ T. _____ N. _____ E. _____ S. _____ R. _____ W. _____		
3. MISCELLANEOUS PROPERTY IN SECTION _____ T. _____ N. _____ E. _____ S. _____ R. _____ W. _____		
4. LOT NO. _____, RECORDED PLAT _____		
5. PRIVATE CLAIMS _____		

ANTRIM COUNTY
 MICHIGAN
 RECEIVED FOR RECORD
 DEC 5 2 00 PM '94
 REGISTER OF DEEDS
 Wanda R. Conway
 REGISTER OF DEEDS STAMP AND FILING NUMBER

I, Terry B. Smith, do hereby certify that under requirements of P.A. 74, Michigan P.A. of 1970, the corner points mentioned in lines 1 and 2 above were, in a field survey on Nov. 23, 1994, established, re-established, monumented, re-monumented, recovered or restored as expressed below and in conformance with regulations and rules therefore as required in the current manual of survey instructions of the United States Department of the Interior, Bureau of Land Management or by a decree of a court of law. Furthermore, that the corner points mentioned in lines 3, 4 and 5 above were, in a field survey on Nov. 23, 1994, found, recovered, restored, established or re-established as expressed below and in conformance with the rules of the Michigan State Board of Registration for Land Surveyors or, by a Decree of a Court of law:

A. Description of original monument and accessories and/or subsequent restoration:

GLO Corner Post Oct. 1855	County Surveyor Fredrick Church
Notes refer to "section corner"	notes sections subdivision
No witnesses given	Aug. 1886
No evidence found	No evidence found

B. Description of corner evidence found and/or method applied in restoring or re-establishing corner:

found 1 1/2" Axle Shaft & witnesses

C. Description of monument for corner and accessories established to perpetuate locating the position of the corner:

C-11 -- SW Corne Sec. 29, T30N, R7W	Ratified by Peer Group
Peer group approval Oct. 6, 1994	in accordance with P.A. 345
Set Antrim County Monument	Chairman <i>[Signature]</i>
8" Maple N45°W 27.2	Arthur L. Lennox
12" Maple N10°W 17.3	Date: Oct. 6, 1994
10" Maple N10°E 10.9	
18" Maple S10°W 32.1	


SIGNED BY Terry B. Smith DATE Nov. 30, 1994

SURVEYOR'S MICHIGAN REGISTRATION NO. 25873

FOR STATE AND UNITED STATES AGENCIES:

SIGNED BY _____ DATE _____

APPROVED AND SIGNED BY _____ DATE _____

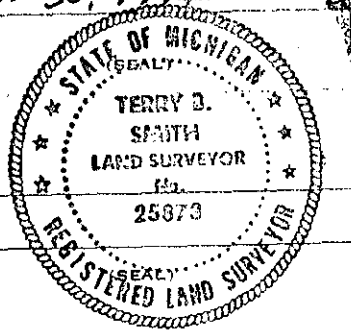

002 232
 SURVEYOR'S MICHIGAN REGISTRATION NO. _____