

**LAND CORNER RECORDATION CERTIFICATE**  
**Filing Requirement of Act 74, Mich. P.A. 1970**

ANTRIM COUNTY  
 MICHIGAN  
 RECEIVED FOR RECORD  
 NOV 30 3 59 PM '94  
 Wanda R. Cunniff  
 REGISTER OF DEEDS

For corners in  
ANTRIM  
 (County)

Located In: SEC 21 Corner Code #

- |                                    |                          |            |
|------------------------------------|--------------------------|------------|
| 1. Public Land Survey              | T <u>30N</u> R <u>7W</u> | <u>E-7</u> |
|                                    | T _____ R _____          | _____      |
|                                    | T _____ R _____          | _____      |
|                                    | T _____ R _____          | _____      |
| 2. Property Controlling In Section | S _____ T _____          | R _____    |
|                                    | S _____ T _____          | R _____    |
| 3. Miscellaneous Property in Sec.  | S _____ T _____          | R _____    |
|                                    | S _____ T _____          | R _____    |

Ratified by Peer

Register of Deeds Stamp & File Number

4. Lot No. \_\_\_\_\_, Recorded Plat \_\_\_\_\_  
 5. Private Claims \_\_\_\_\_ SECTION \_\_\_\_\_

I, NEIL L. WAY, in a field survey on OCT 5, 19 94  
 do hereby certify that under requirements of P.A. 74; Michigan P.A. of 1970, the corner points mentioned in lines 1 and 2 above were in conformance with regulations and rules therefore as required in the current manual of survey instructions of the United States Department of the Interior, Bureau of Land Management or by a decree of a Court of Law and/or that the corner points mentioned in lines 3, 4 and 5 above were in conformance with the rules of the Michigan Board of Land Surveyors or by a Decree of a Court of Law; established, re-established, monumented, re-monumented, recovered, found as expressed below:

**NOTE: Not more than 4 corners, all in the same town and range, may be recorded on this certificate.**

A	B	C	D	E	F	G	H	I	J	K	L
2	6	5	4	3	2	1					
3											
4	7	8	9	10	11	12					
6											
6	18	17	16	15	14	13					
7											
8	19	20	21	22	23	24					
9											
10	30	29	28	27	26	25					
11											
12	31	32	33	34	35	36					
13											

A. Description of original monument and accessories and/or subsequent restoration:

E-7  
 GLO SET CORNER POST OCT 1855  
 BEECH 18 N54W 34  
 SUGAR 14 S28E 20

NO EVIDENCE FOUND


B. Description of corner evidence found and/or method applied in restoring or reestablishing corner:

E-7  
 FOUND 3/8" IRON PIPE OVER 1/2" IRON ROD IN MONUMENT BOX @ 3' WEST OF  $\phi$  ROAD INTERSECTION AND ON LINE WITH OLD FENCE LINE TO SOUTH.

Ratified by Peer Group  
 in accordance with P.A. 345  
 Chairman *Arthur L. Lennox*  
 Arthur L. Lennox  
 Date: Oct. 6, 1994

C. Description of monument for corner and accessories established to perpetuate locating the position of the corner:

E-7  
 SET COUNTY MONUMENT IN MONUMENT BOX  
 S60W 61.83' NORWAY 6"  
 N62E 85.27' ASH 8"  
 N40E 68.50' ASH 3"  
 N45E 46.70' 1/2" IRON AT FENCE COR.

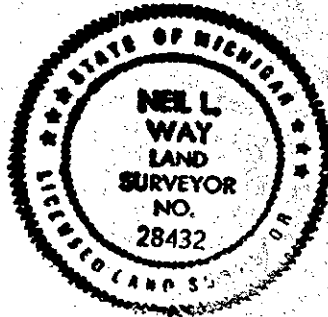

Signed by NEIL L. WAY *Neil L. Way* Date NOV 21, 1994  
 Surveyor's Michigan License No. 28432