

LAND CORNER RECORDATION CERTIFICATE
Filing Requirement of Act 74, Mich. P.A. 1970

For corners in

ANTRIM
(County)

Located in: SEC 21 Corner Code #

- | | | | | | |
|------------------------------------|---|------------|---|-----------|------------|
| 1. Public Land Survey | T | <u>30N</u> | R | <u>7W</u> | <u>G-7</u> |
| | T | | R | | |
| | T | | R | | |
| | T | | R | | |
| 2. Property Controlling in Section | S | | T | | |
| | S | | T | | |
| 3. Miscellaneous Property in Sec. | S | | T | | |
| | S | | T | | |

4. Lot No. _____, Recorded Plat _____
 5. Private Claims _____

ANTRIM COUNTY
 MICHIGAN
 RECEIVED FOR RECORD
 NOV 30 3 41 PM '94
 REGISTER OF DEEDS
W. R. C. County

Register of Deeds Stamp & File Number

I, NEIL L. WAY, in a field survey on OCT 5, 19 94, do hereby certify that under requirements of P.A. 74, Michigan P.A. of 1970, the corner points mentioned in lines 1 and 2 above were in conformance with regulations and rules therefore as required in the current manual of survey instructions of the United States Department of the Interior, Bureau of Land Management or by a decree of a Court of Law and/or that the corner points mentioned in lines 3, 4 and 5 above were in conformance with the rules of the Michigan Board of Land Surveyors or by a Decree of a Court of Law; established, re-established, monumented, re-monumented, recovered, found as expressed below:

A	B	C	D	E	F	G	H	I	J	K	L	M
2	6	5	4	3	2	1						
3												
4	7	8	9	10	11	12						
5												
6	18	17	16	15	14	13						
7												
8	19	20	21	22	23	24						
9												
10	30	29	28	27	26	25						
11												
12	31	32	33	34	35	36						
13												

NOTE: Not more than 4 corners, all in the same town and range, may be recorded on this certificate.

A. Description of original monument and accessories and/or subsequent restoration:

G-7
 GLO SET CORNER POST OCT 1855
 SUGAR 14 N83E 7
 SUGAR 10 SOUTH 11

NO EVIDENCE FOUND


B. Description of corner evidence found and/or method applied in restoring or reestablishing corner:

G-7
 FOUND 1/2" R. ROD 3.5' WEST OF CENTERLINE INTERSECTION OF ROADS E-W AND N AND 8' WEST OF CENTERLINE ROAD TO SOUTH.

Ratified by Peer Group
 in accordance with P.A. 345
 Chairman *[Signature]*
 Arthur L. Lennox
 Date: Oct. 6, 1994

C. Description of monument for corner and accessories established to perpetuate locating the position of the corner:

G-7
 SET COUNTY MONUMENT
 N36W 82.48' MPL 36"
 N55E 51.00' R.PINE 12"
 S35E 36.85' P.POLE
 S11W 51.10' P.POLE

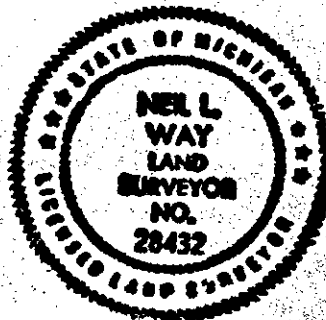

Signed by NEIL L. WAY *[Signature]* Date NOV 21, 1994
 Surveyor's Michigan License No. 28432