

**SURVEY &
REMONUMENTATION
LAND CORNER RECORDATION CERTIFICATE**
APR 26 1995 FILING REQUIREMENT OF ACT 74, MICH. P.A.1970
COMMISSION

FOR CORNERS OF--	LOCATED IN--	CORNER CODE NUMBER
1. PUBLIC LAND SURVEY 28 T. 30 N. 7 E.		G-10
2. PROPERTY CONTROLLING IN SECTION	N. S. R. E. W.	
3. MISCELLANEOUS PROPERTY IN SECTION	N. S. R. E. W.	
4. LOT NO. _____, RECORDED PLAT _____		
5. PRIVATE CLAIMS _____		

ANTRIM COUNTY
MICHIGAN
RECEIVED FOR RECORD
DEC 5 2 00 PM '94
Wanda R. Conway
REGISTER OF DEEDS
REGISTER OF DEEDS STAMP AND
FILING NUMBER

I, Terry B. Smith, do hereby certify that under requirements of P.A. 74, Michigan P.A. of 1970, the corner points mentioned in lines 1 and 2 above were, in a field survey on DEC. 12, 1994, established, re-established, monumented, re-monumented, recovered or restored as expressed below and in conformance with regulations and rules therefore as required in the current manual of survey instructions of the United States Department of the Interior, Bureau of Land Management or by a decree of a court of law. Furthermore, that the corner points mentioned in lines 3, 4 and 5 above were, in a field survey on DEC. 12, 1994, found, recovered, restored, established or re-established as expressed below and in conformance with the rules of the Michigan State Board of Registration for Land Surveyors or, by a Decree of a Court of law:

A. Description of original monument and accessories and/or subsequent restoration:

GLO Corner Post Oct. 1855	July 1976 C. Eugene Ostling #12026
Beech 8 N19W 37	set 1/2"x18" iron at intersection of line from
Elm S1E 26	G-9 to G-11 and straight line from
No evidence found	H-10 and I-10

B. Description of corner evidence found and/or method applied in restoring or re-establishing corner:
found 1/2" iron & witnesses

C. Description of monument for corner and accessories established to perpetuate locating the position of the corner:
G-10 -- E 1/2 Corne Sec. 28, T30N, R7W
Peer group approval Oct. 6, 1994
Set Antrim County Monument
Maple clump N54°W 33.70
Maple S67°W 20.54
GTE phone riser box S66°E 49.8
Utility pole S03°45'E 20.25

Ratified by Peer Group
in accordance with P.A. 345
Chairman Arthur L. Lennox
Date: Oct. 6, 1994


SIGNED BY Terry B. Smith DATE Nov. 30, 1994

SURVEYOR'S MICHIGAN REGISTRATION NO. 25873

FOR STATE AND UNITED STATES AGENCIES:

SIGNED BY _____ DATE _____
CHIEF OF SURVEY PARTY

APPROVED AND SIGNED BY _____ DATE _____
MICHIGAN REGISTERED LAND SURVEYOR

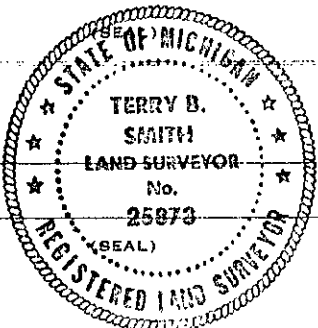

FILED 002 226

SURVEYOR'S MICHIGAN REGISTRATION NO. _____