

LAND CORNER RECORDATION CERTIFICATE
Filing Requirement of Act 74, Mich. P.A. 1970

ANTRIM COUNTY
 MICHIGAN
 RECEIVED FOR RECORD
 NOV 30 4 01 PM '94
 Wanda R. Cunniff
 REGISTER OF DEEDS

or corners in

ANTRIM (County) Located in: SEC 22 Corner Code # H-9

1. Public Land Survey	T 30N	R R7W	H-9
	T	R	
	T	R	
	T	R	
2. Property Controlling in Section	S	T	R
	S	T	R
3. Miscellaneous Property in Sec.	S	T	R
	S	T	R

Register of Deeds Stamp & File Number

4. Lot No. _____, Recorded Plat _____
 5. Private Claims _____

NEIL L. WAY in a field survey on NOV 21, 1994
 do hereby certify that under requirements of P.A. 74, Michigan P.A. of 1970, the corner points mentioned in lines 1 and 2 above were in conformance with regulations and rules therefore as required in the current manual of survey instructions of the United States Department of the Interior, Bureau of Land Management or by a decree of a Court of Law and/or that the corner points mentioned in lines 3, 4 and 5 above were in conformance with the rules of the Michigan Board of Land Surveyors or by a Decree of a Court of Law; established, re-established, monumented, re-monumented; recovered, found as expressed below:

A	B	C	D	E	F	G	H	I	J	K	L	M
2	6	5	4	3	2	1						
3												
4	7	8	9	10	11	12						
5												
6	18	17	16	15	14	13						
7												
8	19	20	21	22	23	24						
9												
10	30	29	28	27	26	25						
11												
12	31	32	33	34	35	36						
13												

NOTE: Not more than 4 corners, all in the same town and range, may be recorded on this certificate.

A. Description of original monument and accessories and/or subsequent restoration:

H-9
 glo set cor post OCT 1855
 cedar 14 N22W 19
 HEMLOCK 8 S22E 16

**SURVEY &
 REMONUMENTATION**
 JUL 1 1 1996
 COMMISSION

NO EVIDENCE FOUND


B. Description of corner evidence found and/or method applied in restoring or reestablishing corner:

H-9
 FOUND 1/2" IRON AND CAP OSTLING

Rectified by Peer Group
 in accordance with P.A. 74
 Whitham
 Nov 1, 1994
 Filed Oct. 6, 1994

C. Description of monument for corner and accessories established to perpetuate locating the position of the corner:

H-9
 SET COUNTY MONUMENT
 S30E 4.25' MPL 6"
 S70W 20.22' BALSME 12"
 N27E 12.88' BALSME 4"
 N85W 22.40' MPL 10"

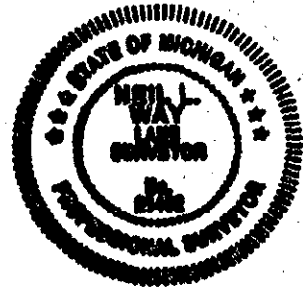

Signed by NEIL L. WAY Date NOV 21, 1994
 Surveyor's Michigan License No. 28432

11889 002 214