

**SURVEY &  
REMONUMENTATION**

**LAND CORNER RECORDATION CERTIFICATE**

APR 26 1995 FILING REQUIREMENT OF ACT 74, MICH. P.A. 1970

**COMMISSION**

FOR CORNERS OF--:	LOCATED IN--:	CORNER CODE NUMBER
1. PUBLIC LAND SURVEY <u>27</u> T. <u>30</u> <u>N.</u> S. <u>7</u> <u>E.</u> R. <u>W.</u>		H-11
2. PROPERTY CONTROLLING IN SECTION _____, T. _____, N. S., R. _____, E. W.		
3. MISCELLANEOUS PROPERTY IN SECTION _____, T. _____, N. S., R. _____, E. W.		
4. LOT NO. _____, RECORDED PLAT _____		
5. PRIVATE CLAIMS _____		

ANTRIM COUNTY  
 MICHIGAN  
 RECEIVED FOR RECORD  
 DEC 5 2 06 PM '94  
 Wanda R. Conway  
 REGISTER OF DEEDS  
 REGISTER OF DEEDS STAMP AND FILING NUMBER

I, Terry B. Smith, do hereby certify that under requirements of P.A. 74, Michigan P.A. of 1970, the corner points mentioned in lines 1 and 2 above were, in a field survey on DEC 13, 1994, established, re-established, monumented, re-monumented, recovered or restored as expressed below and in conformance with regulations and rules therefore as required in the current manual of survey instructions of the United States Department of the Interior, Bureau of Land Management or by a decree of a court of law. Furthermore, that the corner points mentioned in lines 3, 4 and 5 above were, in a field survey on DEC 13, 1994, found, recovered, restored, established or re-established as expressed below and in conformance with the rules of the Michigan State Board of Registration for Land Surveyors or, by a Decree of a Court of law:

A. Description of original monument and accessories and/or subsequent restoration:

GLO Corner Post Oct. 1855      June 1991 recorded Liber 002 page 125  
 Beech 12 N20W 42      LCRC by LS#28415 John McLane  
 Beech 9 S20E 9  
 No evidence found

B. Description of corner evidence found and/or method applied in restoring or re-establishing corner:

found 1/2" iron bar & witnesses

C. Description of monument for corner and accessories established to perpetuate locating the position of the corner:

H-11 -- S 1/4 Corne Sec. 27, T30N, R7W  
 Peer group approval Oct. 6, 1994  
 Set Antrim County Monument  
 8" Basswood N50°E 4.7  
 6" Maple N60°E 23.5  
 8" Maple N50°W 4.5  
 RR Spike N27°W 277.02

Ratified by Peer Group  
 in accordance with P.A. 345  
 Chairman [Signature]  
 Arthur L. Lennox  
 Date: Oct. 6, 1994


SIGNED BY Terry B. Smith DATE NOV. 30, 1994

SURVEYOR'S MICHIGAN REGISTRATION NO. 25873

FOR STATE AND UNITED STATES AGENCIES:

SIGNED BY \_\_\_\_\_ DATE \_\_\_\_\_  
CHIEF OF SURVEY PARTY

APPROVED AND SIGNED BY \_\_\_\_\_ DATE \_\_\_\_\_  
MICHIGAN REGISTERED LAND SURVEYOR

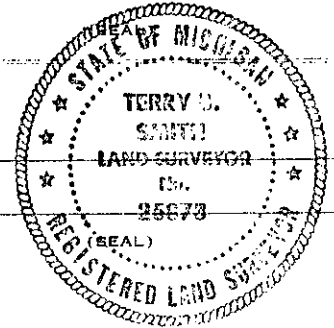

902 215

SURVEYOR'S MICHIGAN REGISTRATION NO. \_\_\_\_\_