

LAND CORNER RECORDATION CERTIFICATE
Filing Requirement of Act 74, Mich. P.A. 1970

ANTRIM COUNTY
 MICHIGAN
 RECEIVED FOR RECORD
 NOV 30 3 53 PM 1994
 REGISTER OF DEEDS
 Deane R. C...
 REGISTER OF DEEDS

For corners in
ANTRIM
 (County)

Located In: SEC 22 Corner Code #

- | | | |
|------------------------------------|--------------------------|-------------------------------------|
| 1. Public Land Survey | T <u>30N</u> R <u>7W</u> | <u>I-9</u> |
| | T _____ R _____ | _____ |
| | T _____ R _____ | _____ |
| | T _____ R _____ | _____ |
| 2. Property Controlling in Section | S _____ T _____ R _____ | <u>SURVEY & REMONUMENTATION</u> |
| 3. Miscellaneous Property in Sec. | S _____ T _____ R _____ | _____ |
| | S _____ T _____ R _____ | _____ |

Register of Deeds Stamp & File Number

4. Lot No. _____, Recorded Plat _____
 5. Private Claims _____ SECTION _____

	A	B	C	D	E	F	G	H	I	J	K	L	M
2	6	5	4	3	2	1							
3													
4	7	8	9	10	11	12							
5													
6	18	17	16	15	14	13							
7													
8	19	20	21	22	23	24							
9													
10	30	29	28	27	26	25							
11													
12	31	32	33	34	35	36							
13													

I, NEIL L. WAY, in a field survey on OCT 5, 1994, do hereby certify that under requirements of P.A. 74, Michigan P.A. of 1970, the corner points mentioned in lines 1 and 2 above were in conformance with regulations and rules therefore as required in the current manual of survey instructions of the United States Department of the Interior, Bureau of Land Management or by a decree of a Court of Law and/or that the corner points mentioned in lines 3, 4 and 5 above were in conformance with the rules of the Michigan Board of Land Surveyors or by a Decree of a Court of Law; established, re-established, monumented, re-monumented, recovered, found as expressed below:

NOTE: Not more than 4 corners, all in the same town and range, may be recorded on this certificate.

A. Description of original monument and accessories and/or subsequent restoration:

I-9
 GLO SET CORNER POST OCT 1855
 CEDAR 16 N37W 14
 CEDAR 18 S37E 34

NO EVIDENCE FOUND


B. Description of corner evidence found and/or method applied in restoring or reestablishing corner:

I-9
 FOUND NO CORNER, RESET AT LOCATION FROM WITNESSES ON LCR LIB 001 PG 243

Ratified by Peer Group
 in accordance with P.A. 345
 Chairman Arthur L. Lennox
 Date: Oct. 6, 1994

C. Description of monument for corner and accessories established to perpetuate locating the position of the corner:

I-9
 SET COUNTY MONUMENT
 S10W 20.83' CEDAR 10"
 N40W 17.14' CEDAR 6"
 N10W 37.87' CEDAR 8"
 S15W 10.65' X ON W END CULVERT
 EAST 10.60' CENTERLINE N-S ROAR

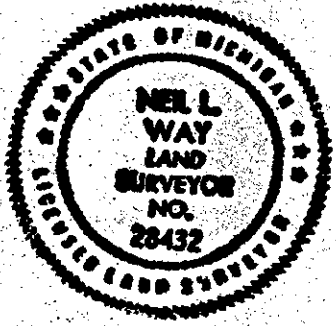

Signed by NEIL L. WAY Neil L. Way Date NOV 21, 1994
 Surveyor's Michigan License No. 28432

002 206