

LAND CORNER RECORDATION CERTIFICATE
Filing Requirement of Act 74, Mich. P.A. 1970

ANTRIM COUNTY
 MICHIGAN
 RECEIVED FOR RECORD
 NOV 30 3 55 PM '94
 Wanda R. Cusack
 REGISTER OF DEEDS

For corners in

ANTRIM
 (County)

Located In: SEC 23 Corner Code #

- | | | | |
|------------------------------------|--------------|-------------|------------|
| 1. Public Land Survey | T <u>30N</u> | R <u>7W</u> | <u>K-9</u> |
| | T | R | |
| | T | R | |
| | T | R | |
| 2. Property Controlling in Section | S | T | R |
| 3. Miscellaneous Property in Sec. | S | T | R |
| | S | T | R |

Register of Deeds Stamp & File Number

4. Lot No. _____, Recorded Plat _____ SECTION _____
 5. Private Claims _____

	A	B	C	D	E	F	G	H	I	J	K	L	M
2	6		5		4		3		2		1		
3													
4	7		8		9		10		11		12		
5													
6	18		17		16		15		14		13		
7													
8	19		20		21		22		23		24		
9													
10	30		29		28		27		26		25		
11													
12	31		32		33		34		35		36		
13													

I, NEIL L. WAY, in a field survey on OCT 5, 1994, do hereby certify that under requirements of P.A. 74, Michigan P.A. of 1970, the corner points mentioned in lines 1 and 2 above were in conformance with regulations and rules therefore as required in the current manual of survey instructions of the United States Department of the Interior, Bureau of Land Management or by a decree of a Court of Law and/or that the corner points mentioned in lines 3, 4 and 5 above were in conformance with the rules of the Michigan Board of Land Surveyors or by a Decree of a Court of Law; established, re-established, monumented, re-monumented, recovered, found as expressed below:

NOTE: Not more than 4 corners, all in the same town and range, may be recorded on this certificate.

A. Description of original monument and accessories and/or subsequent restoration:

K-9
 GLO SET CORNER POST OCT 1855
 CEDAR 12 N32W 15
 CEDAR 12 S42E 17

NO EVIDENCE FOUND


B. Description of corner evidence found and/or method applied in restoring or reestablishing corner:

K-9
 FOUND 1/2" IRON AND CAP #14200 CHENARD

Ratified by Peer Group
 in accordance with P.A. 345
 Chairman Arthur Lennox
 Date: Oct. 6, 1994

C. Description of monument for corner and accessories established to perpetuate locating the position of the corner:

K-9
 SET COUNTY MONUMENT OVER FOUND 1/2" IRON
 N65W 25.30' CEDAR 3"
 S12E 13.58' CEDAR 8"
 N86E 12.11' CEDAR 8"
 N52E 10.30' CEDAR 12"
 N32W 9.90' CEDAR STUMP

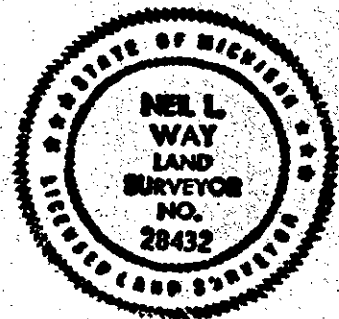

Signed by NEIL L. WAY Neil L. Way Date NOV 21, 1994

Surveyor's Michigan License No. 28432