


STATE OF MICHIGAN
DEPARTMENT
OF
NATURAL RESOURCES

LAND CORNER RECORD

ANTRIM COUNTY
T 31 N R 8 W

DESCRIPTION OF CORNER S 1/4 corner, Section 4
CORNER MONUMENT Set DNR Monument & Cedar post w/location tag
DATE MONUMENT PLACED AND WITNESSED 11-10-71
WITNESSES TO CORNER..... 7" twin Maple S 80 W 34.2'

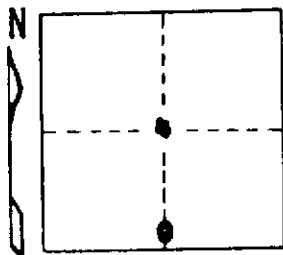


9" twin B. Cherry N 60 W 102.4'
10" Maple N 72 E 67.6'
AND
E-W Random Due S 177'

CIRCLE CORNER REGISTERED

DESCRIPTION IN DETAIL AS TO HOW CORNER WAS LOCATED AND IDENTIFIED OR RESTORED.

Corner reestablished per standard BLM instructions. Corner falls 3' N of irregular fence remains West and 4' W of fence to South. No corner fence post evident.

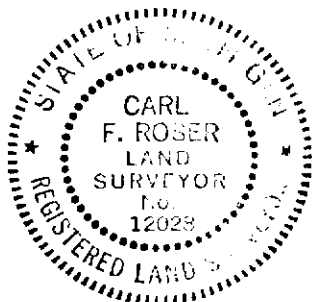

SURVEYOR'S SEAL

SIGNED Carl F. Rober DATE 11-17-71
REGISTERED LAND SURVEYOR 12028

DISTRIBUTION:

County Courthouse
Area Forester (Regions I & II)
District or Region Surveyor
Forestry Div., Lansing

R 4047
Rev. 10/68