

STATE OF MICHIGAN  
DEPARTMENT  
OF  
NATURAL RESOURCES

LAND CORNER RECORD


ANTRIM COUNTY  
T 31 N R 5 W

DESCRIPTION OF CORNER W 1/4 on S line of Section 4

CORNER MONUMENT Set 1"x20" pipe & Cedar Post with location tag

DATE MONUMENT PLACED AND WITNESSED 11-10-71

WITNESSES TO CORNER..... 10" Maple N 78 W 22.0'

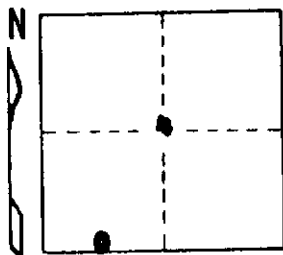

8" Maple S 3 E 22.8'


10" Maple N 50 E 8.4'

AND E-W Random Due S 220±

CIRCLE CORNER REGISTERED

DESCRIPTION IN DETAIL AS TO HOW CORNER WAS LOCATED AND IDENTIFIED OR RESTORED.

**Corner established per standard BLM instructions. Corner falls 5' N of irregular E-W fence remains.**

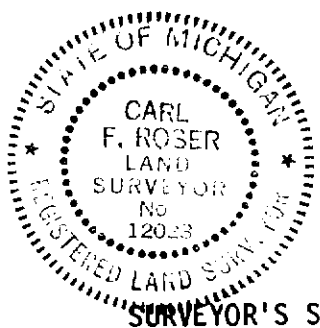

SURVEYOR'S SEAL

SIGNED

Carl F. Roser  
REGISTERED LAND SURVEYOR

DATE

11-17-71

DISTRIBUTION:

12028

County Courthouse  
Area Forester (Regions I & II)  
District or Region Surveyor  
Forestry Div., Lansing

R 4047  
Rev. 10/68