

STATE OF MICHIGAN
DEPARTMENT
OF
NATURAL RESOURCES

LAND CORNER RECORD


ANTRIM COUNTY
T 81 N R 6 W

DESCRIPTION OF CORNER NW corner Section 4

CORNER MONUMENT Set DNR Monument

DATE MONUMENT PLACED AND WITNESSED 11-19-71

WITNESSES TO CORNER..... 9" Y. Birch N 89 E 17.2'

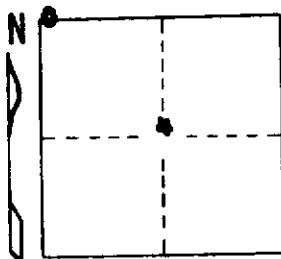

9" Maple N 10 E 11.2'


7" Ironwood S 37 W 30.6'

AND E-W Random Due S 225'

CIRCLE CORNER REGISTERED

DESCRIPTION IN DETAIL AS TO HOW CORNER WAS LOCATED AND IDENTIFIED OR RESTORED.

Corner reestablished per standard BLM instructions.

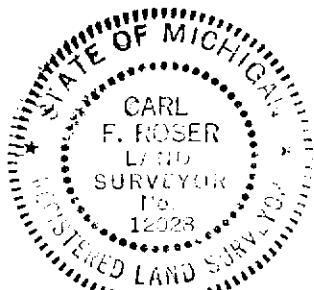

SURVEYOR'S SEAL

SIGNED Carl F. Roser DATE 11-26-71
REGISTERED LAND SURVEYOR 12028

DISTRIBUTION:

County Courthouse
Area Forester (Regions I & II)
District or Region Surveyor
Forestry Div., Lansing