

STATE OF MICHIGAN
DEPARTMENT
OF
NATURAL RESOURCES

LAND CORNER RECORD


ANTRIM COUNTY
T 31 N R 5 W

DESCRIPTION OF CORNER N 1/4 corner section 4

CORNER MONUMENT Set DNR Monument

DATE MONUMENT PLACED AND WITNESSED 11-19-71

WITNESSES TO CORNER..... 10" Maple S 8 W 35.0'

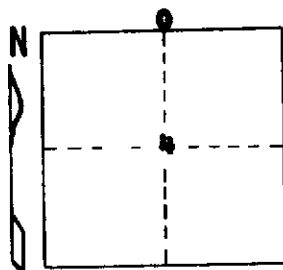

7" Ironwood S 83 W 48.0'


P. Pole (High Line) N 31 W 60.45'

AND E-W Random Dec 8 151.8'

CIRCLE CORNER REGISTERED

DESCRIPTION IN DETAIL AS TO HOW CORNER WAS LOCATED AND IDENTIFIED OR RESTORED.

Corner reestablished per Standard BLM instructions.

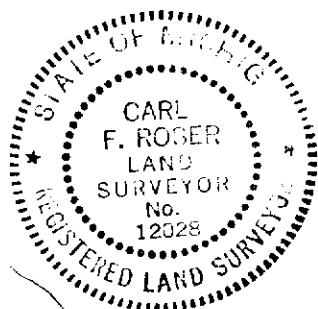

SURVEYOR'S SEAL

SIGNED Carl F. Roger DATE 11-26-71
REGISTERED LAND SURVEYOR **12028**

DISTRIBUTION:

County Courthouse
Area Forester (Regions I & II)
District or Region Surveyor
Forestry Div., Lansing

R 4047
Rev. 10/68