


STATE OF MICHIGAN
DEPARTMENT
OF
NATURAL RESOURCES

LAND CORNER RECORD

ANTRIM COUNTY
T 31 N R 5 W

DESCRIPTION OF CORNER N 1/4 corner, Section 3
CORNER MONUMENT Set DNR Mon. by found stake bottom.
DATE MONUMENT PLACED AND WITNESSED 11-19-71

WITNESSES TO CORNER..... 8" Ironwood N 87 W 32.8'

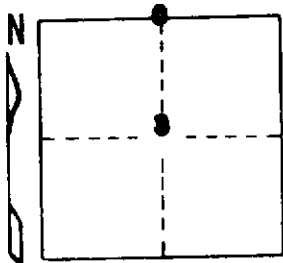

9" Maple S 31 E 18.9'


10" Maple N 62 E 23.5'

AND E-W Random Due S 20'

CIRCLE CORNER REGISTERED

DESCRIPTION IN DETAIL AS TO HOW CORNER WAS LOCATED AND IDENTIFIED OR RESTORED.

Recovered stake bottom and part of upper stake from old witness SW & NE as noted in old County Surveyors Book C-302 at Charlevoix County Reg. of Deeds.

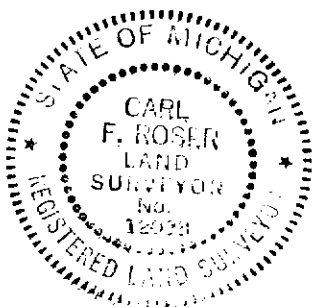

SURVEYOR'S SEAL

SIGNED Carl F. Roser DATE 11-26-71
REGISTERED LAND SURVEYOR 12028

DISTRIBUTION:

County Courthouse
Area Forester (Regions I & II)
District or Region Surveyor
Forestry Div., Lansing