


STATE OF MICHIGAN
DEPARTMENT
OF
NATURAL RESOURCES

LAND CORNER RECORD

ANTRIM COUNTY
T 31 N R 8 W

DESCRIPTION OF CORNER NW corner, Section 2
CORNER MONUMENT Set DMB monument by end fence post in E-W fence
remains at position of found pointed stake bottom
DATE MONUMENT PLACED AND WITNESSED 8-19-70
WITNESSES TO CORNER..... 9" Cedar N 47 E 61.0'

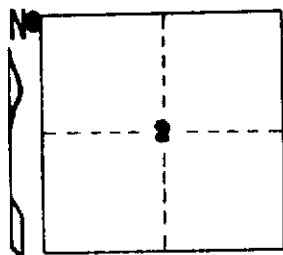

20" W. Pine Stump N 51 E 48.0'
10" Cedar S 71 E 64.1'
AND
E-W Random Due S 4'

CIRCLE CORNER REGISTERED


DESCRIPTION IN DETAIL AS TO HOW CORNER WAS LOCATED AND IDENTIFIED OR RESTORED.

Possible U.S.B.T.'s (Cedar Stumps) NE & SE.

Found pointed stk bottom from old witness (Probably Robinson's about 1906) as noted in old survey book C-302 at Charlevoix Co. Register of Deeds. Wit. found as stumps with lower face:

14" Cedar S 18 E 4.0'
12" Cedar N 88 W 15.2'

Corner also fits ties to old R.R. grade, Boyne City S.E., as noted in old Sur. Book C-306 at Charlevoix Co. Reg. of Deeds.

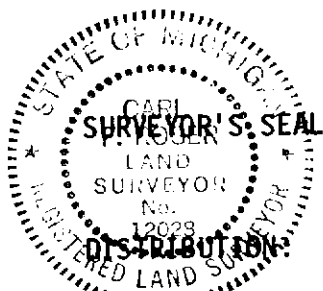

SIGNED [Signature] DATE 12-22-71
REGISTERED LAND SURVEYOR 12028

County Courthouse
Area Forester (Regions I & II)
District or Region Surveyor
Forestry Div., Lansing