

STATE OF MICHIGAN
DEPARTMENT
OF
NATURAL RESOURCES

LAND CORNER RECORD


ANTRIM COUNTY
T 31 N R 5 W

DESCRIPTION OF CORNER N 1/4 corner, Section 2

CORNER MONUMENT Found 1/2" pipe over axle shaft

DATE MONUMENT PLACED AND WITNESSED 10-22-71

WITNESSES TO CORNER.....

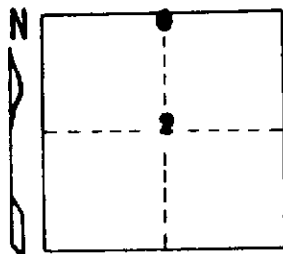


14" Apple	N 60 W	56.21'
Power Pole	N 15 W	141.2'
AND Ctr. US-181	Dec E	98.95'

CIRCLE CORNER REGISTERED

DESCRIPTION IN DETAIL AS TO HOW CORNER WAS LOCATED AND IDENTIFIED OR RESTORED.

Found axle shaft as recovered by M.S.N.D. (Geo. Blass) in November 1946. Corner also noted in old County Surveyor notes at Charlevoix County Reg. of Deeds, Book C-302.

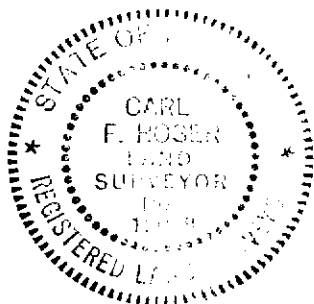

SURVEYOR'S SEAL

SIGNED Carl F. Rose DATE 10-29-71
REGISTERED LAND SURVEYOR 12028

DISTRIBUTION:

County Courthouse
Area Forester (Regions I & II)
District or Region Surveyor
Forestry Div., Lansing

R 4047
Rev. 10/68