


STATE OF MICHIGAN
DEPARTMENT
OF
NATURAL RESOURCES

LAND CORNER RECORD

ANTRIM COUNTY
T 31 N R 8 W

DESCRIPTION OF CORNER SE corner of Sec. 2
CORNER MONUMENT Set DNR Monument, buried 1'
DATE MONUMENT PLACED AND WITNESSED 10-20-71
WITNESSES TO CORNER..... 5" Ironwood N 55 E 69.3'

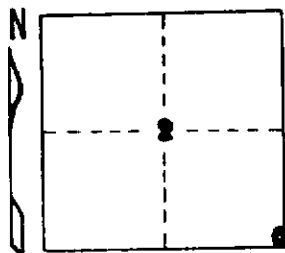


12" Tv. Cedar N 7 W 85.7'
Ctr. R. R. Tracks Due N 9'
Ctr. R. R. Tracks Due E 9'
AND Set 5" Cedar Post Due W 16.5'

CIRCLE CORNER REGISTERED

DESCRIPTION IN DETAIL AS TO HOW CORNER WAS LOCATED AND IDENTIFIED OR RESTORED.

Restored corner at proportionate distances to U.S. and on straight line between section corner 1 mile S and 1/4 corner 1/2 mile N. This fits U.S. tied to top and bottom of hill and stream to West, and hill, swamp & stream tie to South. U.S. run their line straight North three miles from the center of the Twp.

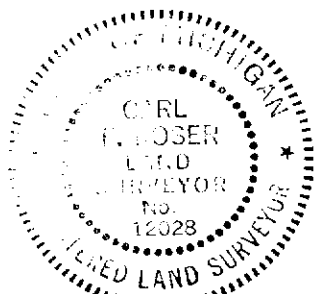

SURVEYOR'S SEAL

SIGNED Carl F. Rose DATE 10-27-71
REGISTERED LAND SURVEYOR 12028

DISTRIBUTION:

County Courthouse
Area Forester (Regions I & II)
District or Region Surveyor
Forestry Div., Lansing

R 4047
Rev. 10/68