


STATE OF MICHIGAN
DEPARTMENT
OF
NATURAL RESOURCES

LAND CORNER RECORD

ANTRIM COUNTY
T 31 N R 5 W

DESCRIPTION OF CORNER Ctr. of SE 1/4 of Sec. 2
CORNER MONUMENT Set 1"x36" pipe
DATE MONUMENT PLACED AND WITNESSED 10-22-71
WITNESSES TO CORNER..... 8" Cedar S 34 E 76.20'

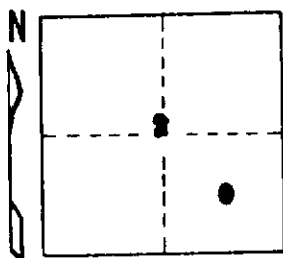


10" Cedar S 45 E 89.10'
9" Maple N 90 E 54.80'
AND N-S Pn. (irregular) Due W 24'

CIRCLE CORNER REGISTERED

DESCRIPTION IN DETAIL AS TO HOW CORNER WAS LOCATED AND IDENTIFIED OR RESTORED.

Corner established per Standard BLM instructions.

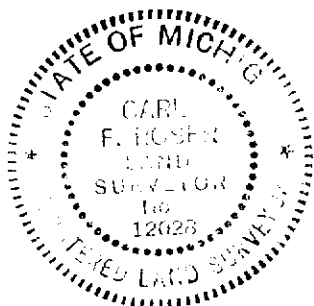

SURVEYOR'S SEAL

SIGNED Carl F. Rosen DATE 10-29-71
REGISTERED LAND SURVEYOR 12028

DISTRIBUTION:

County Courthouse
Area Forester (Regions I & II)
District or Region Surveyor
Forestry Div., Lansing

R 4047
Rev. 10/68