


STATE OF MICHIGAN
DEPARTMENT
OF
NATURAL RESOURCES

LAND CORNER RECORD

ANTRIM COUNTY
T 31 N R 5 W

DESCRIPTION OF CORNER S 1/16 corner on E. line of Sec. 2
CORNER MONUMENT Set 1"x36" pipe
DATE MONUMENT PLACED AND WITNESSED 10-21-71
WITNESSES TO CORNER..... 4" Maple N 67 E 26.4'

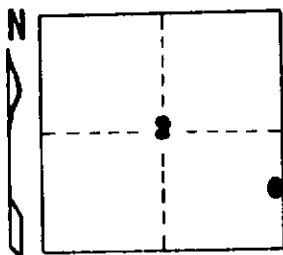


10" Twin Maple S 61 W 50.0'
8" Twin Maple N 70 W 28.1'
AND

CIRCLE CORNER REGISTERED

DESCRIPTION IN DETAIL AS TO HOW CORNER WAS LOCATED AND IDENTIFIED OR RESTORED.

Established corner per standard BLM instructions.

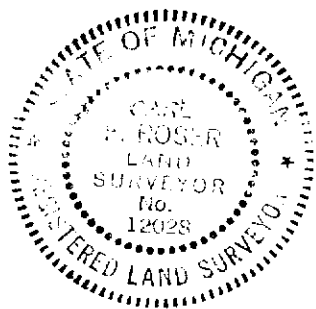

SURVEYOR'S SEAL

SIGNED Carl F. Roser DATE 10-28-71
REGISTERED LAND SURVEYOR 12028

DISTRIBUTION:

County Courthouse
Area Forester (Regions I & II)
District or Region Surveyor
Forestry Div., Lansing

R 4047
Rev. 10/68